
APPENDIX D

System Drawings

UNITED STATES ENVIRONMENTAL PROTECTION AGENCY
REGION IX

NEWMARK OU REMEDIAL DESIGN
NEWMARK GROUNDWATER
CONTAMINATION SUPERFUND SITE
NORTH & SOUTH PLANTS

PREPARED BY
URS CONSULTANTS, INC.
SACRAMENTO, CA

JUNE 1997



"RECORD DRAWING"

SHEET INDEX

GENERAL

1. G-1 COVER SHEET
2. G-2 SHEET INDEX AND GENERAL NOTES
3. G-3 VICINITY AND LOCATION MAPS
4. G-4 LEGEND AND SYMBOLS

PROCESS

5. P-1 NORTH PLANT PROCESS DIAGRAM
6. P-2 NORTH PLANT PIPING AND INSTRUMENTATION DIAGRAM (1 OF 4)
7. P-3 NORTH PLANT PIPING AND INSTRUMENTATION DIAGRAM (2 OF 4)
8. P-4 NORTH PLANT PIPING AND INSTRUMENTATION DIAGRAM (3 OF 4)
9. P-5 NORTH PLANT PIPING AND INSTRUMENTATION DIAGRAM (4 OF 4)
10. P-6 NORTH PLANT CARBON UNITS VALVE SCHEDULE
11. P-7 WATERMAN PLANT PROCESS FLOW DIAGRAM
12. P-8 WATERMAN PLANT PIPING AND INSTRUMENTATION DIAGRAM (1 OF 4)
13. P-9 WATERMAN PLANT PIPING AND INSTRUMENTATION DIAGRAM (2 OF 4)
14. P-10 WATERMAN PLANT PIPING AND INSTRUMENTATION DIAGRAM (3 OF 4)
15. P-11 WATERMAN PLANT PIPING AND INSTRUMENTATION DIAGRAM (4 OF 4)
16. P-12 WATERMAN PLANT CARBON UNITS VALVE SCHEDULE

CIVIL

- | | | |
|-----|------|---|
| 17. | C-1 | NORTH PLANT DEMOLITION PLAN |
| 18. | C-2 | NORTH PLANT SITE PAVING AND GRADING |
| 19. | C-3 | NORTH PLANT YARD PIPING |
| 20. | C-4 | NORTH PLANT SITE LAYOUT |
| 21. | C-5 | NORTH PLANT CARBON TREATMENT SYSTEM LAYOUT |
| 22. | C-6 | NORTH PLANT PIPING AND BACKWASH DRAIN PLAN AND SECTIONS |
| 23. | C-7 | WATERMAN DEMOLITION PLAN |
| 24. | C-8 | WATERMAN SITE PAVING AND GRADING |
| 25. | C-9 | WATERMAN YARD PIPING |
| 26. | C-10 | WATERMAN SITE LAYOUT |
| 27. | C-11 | WATERMAN CARBON TREATMENT SYSTEM LAYOUT |
| 28. | C-12 | WATERMAN PIPING AND BACKWASH DRAIN PLAN AND SECTIONS |
| 29. | C-13 | STANDARD DETAILS |
| 30. | C-14 | STANDARD DETAILS |

STRUCTURAL

- | | | |
|-----|-----|--------------------------------|
| 31. | S-1 | NORTH PLANT STRUCTURAL DETAILS |
| 32. | S-2 | WATERMAN STRUCTURAL DETAILS |
| 33. | S-3 | CONCRETE DETAILS |



ELECTRICAL

- | | | |
|-----|-----|--|
| 34. | E-1 | CARBON FILTERS MONITOR PANEL |
| 35. | E-2 | CARBON FILTER PANEL PLC DIAGRAMS |
| 36. | E-3 | CARBON FILTER / WATERMAN ELECTRICAL SITE PLAN |
| 37. | E-4 | CARBON FILTER / NORTH PLANT ELECTRICAL SITE PLAN |
| | E-5 | - SHEET NOT USED - |
| 38. | E-6 | ELECTRICAL DETAILS |
| 39. | E-7 | CONTROL BUILDING NORTH PLANT |


GENERAL NOTES

1. ENGINEER DOES NOT WARRANT THAT ALL UTILITIES ARE SHOWN, THAT UTILITIES SHOWN EXIST OR THAT UTILITIES SHOWN ARE IN THE LOCATIONS INDICATED. CONTRACTOR SHALL USE EXTREME CAUTION WHEN EXCAVATING FOR PADS, PIPELINES, STRUCTURES AND APPURTENANCES SO AS NOT TO DISTURB EXISTING UTILITIES AND PIPELINES OR UNNECESSARILY DAMAGE SURROUNDING VEGETATION. CONTRACTOR SHALL REROUTE, REPLACE OR, EXTEND OR OTHERWISE ALTER EXISTING UNDERGROUND UTILITIES AND CONDUITS WHICH ARE DISTURBED AS PART OF THIS WORK TO THE ULTIMATE SATISFACTION OF THE ENGINEER AT NO ADDITIONAL COST TO THE OWNER UNLESS APPROVED BY THE ENGINEER IN ADVANCE. CONTRACTOR SHALL NOTIFY UNDERGROUND SERVICE ALERT AT LEAST 48 HOURS IN ADVANCE OF ANY DIGGING. UNDERGROUND SERVICE ALERT TELEPHONE NUMBER: 1-800-642-2444.
2. NORTH PLANT BENCHMARK (ELEV. 1409.941 FEET) IS A 2" BRASS DISK STAMPED "R. CLARK WILSON, L. S. 3223" LOCATED 3 FEET EAST OF THE WEST END OF A CONCRETE HEADWALL OF A FLOOD CONTROL BRIDGE OVER THE DEVIL CREEK CHANNEL NORTH OF 42nd STREET ON LITTLE MOUNTAIN DRIVE. CITY OF SAN BERNARDINO DESIGNATION A6-13A, SET 1985.
3. WATERMAN (SOUTH) PLANT SITE BENCHMARK (ELEV. 1240.802 FEET) IS A BRASS DISK STAMPED "X-522" LOCATED AT THE SOUTHWEST CORNER OF SIERRA WAY AND MARSHALL BLVD. IN THE TOP OF THE SOUTHEAST CORNER OF A CONCRETE FOUNDATION FOR A LIGHT STANDARD AND OVERHEAD STREET LIGHT; 0.9 FEET WEST OF THE WEST CURB LINE OF SIERRA WAY; 13.9 FEET SOUTH OF THE SOUTH CURBLINE OF MARSHALL BLVD. CITY OF SAN BERNARDINO DESIGNATION A6-2, SET 1972.
4. CONTRACTOR AGREES TO ASSUME RESPONSIBILITY FOR SITE CONDITIONS, TO ENSURE THE SAFETY OF ALL PERSONS AND PROPERTY AFFECTED BY THEIR WORK, AND THAT THIS REQUIREMENT SHALL APPLY CONTINUOUSLY AND NOT BE LIMITED TO NORMAL WORKING HOURS.
5. CONTRACTOR ASSUMES FULL RESPONSIBILITY FOR PROTECTION OF EXISTING FACILITIES FROM DAMAGE DUE TO CONTRACTOR'S OPERATIONS.
6. CONTRACTOR AGREES TO ENSURE THAT ALL WORK IS PERFORMED IN A MANNER WHICH MINIMIZES DISTURBANCE TO OWNER'S ONGOING ACTIVITIES AT THE SITE. CONTRACTOR SHALL ENFORCE STRICT DISCIPLINE AND GOOD ORDER AMONG ITS EMPLOYEES AT ALL TIMES. CONTRACTOR SHALL NOT EMPLOY ANY PERSON UNFIT OR UNSKILLED IN ANY PROJECT ASSIGNED TO HIM.

"RECORD DRAWING"

				DESIGNED BY: PS		 URS URS Consultants, Inc. CONSULTING ENGINEERS SACRAMENTO CALIFORNIA		NEWMARK OU REMEDIAL DESIGN NEWMARK GROUNDWATER CONTAMINATION SUPERFUND SITE NORTH & SOUTH PLANTS	SHEET INDEX AND GENERAL NOTES		
11/98 RECORD DRAWING		DRAWN BY: NDH		JOB No. 62370	Scale: NONE				Date: 9/97	Dwg. No.: G-2	
NO.	DATE	DESCRIPTION	NO.		DATE				DESCRIPTION		
REVISIONS											


JOB No. 62370.50 No. 11/98 PROJECT: NEWMARK ASBUILT G-3.DGN

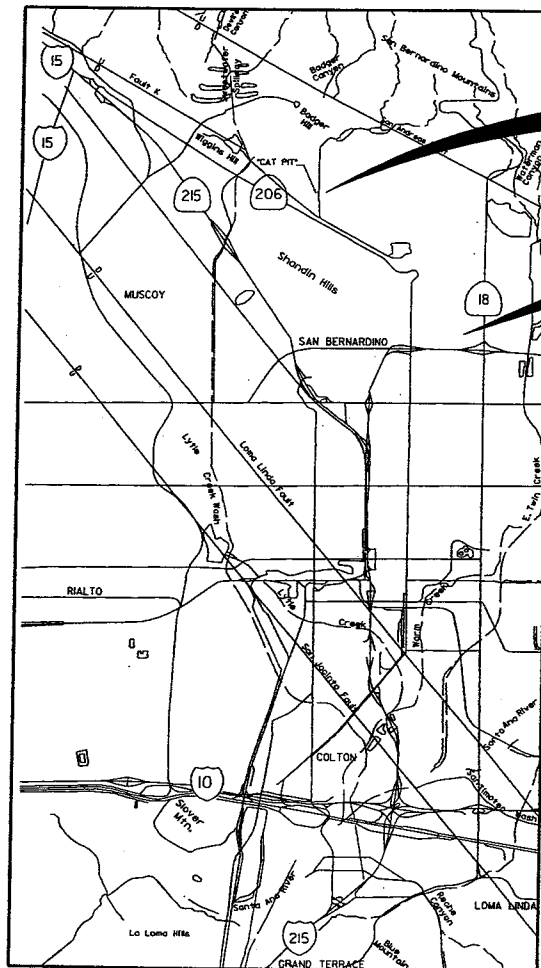


VICINITY MAP

NORTH PLANT
TREATMENT FACILITIES

WATERMAN PLANT
TREATMENT FACILITIES

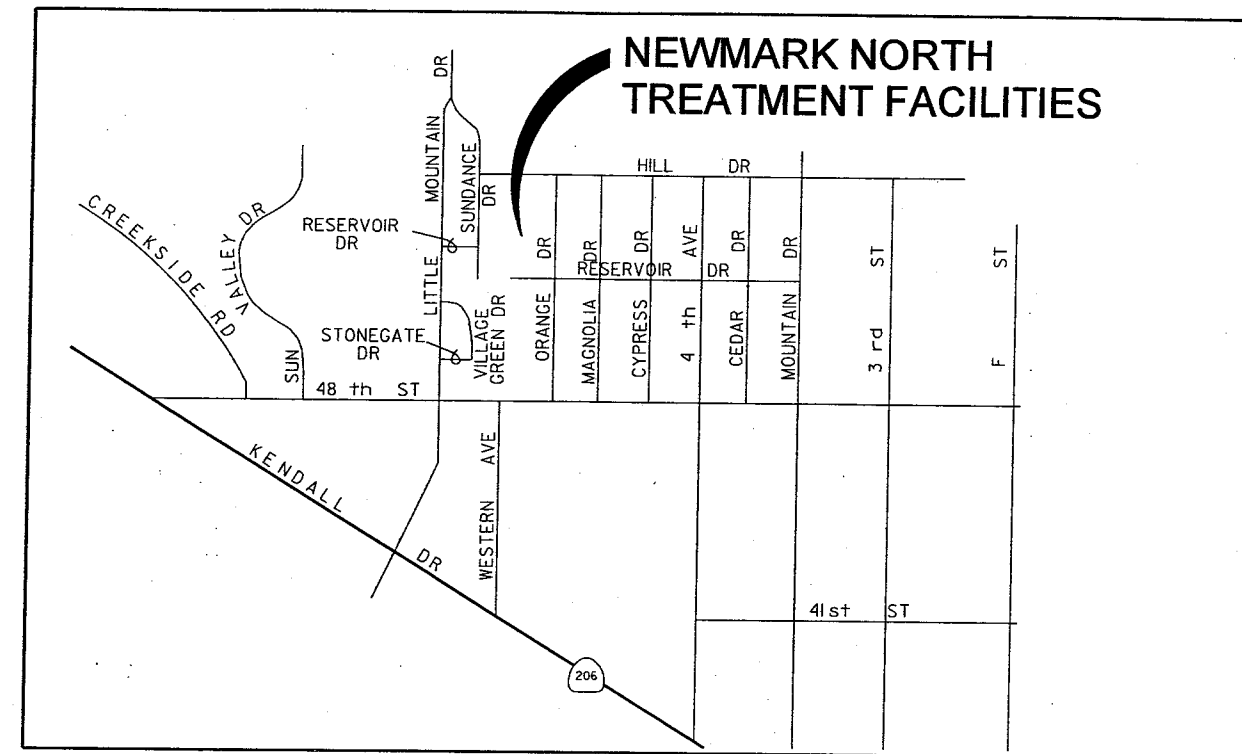

NORTH PLANT
LOCATION MAP

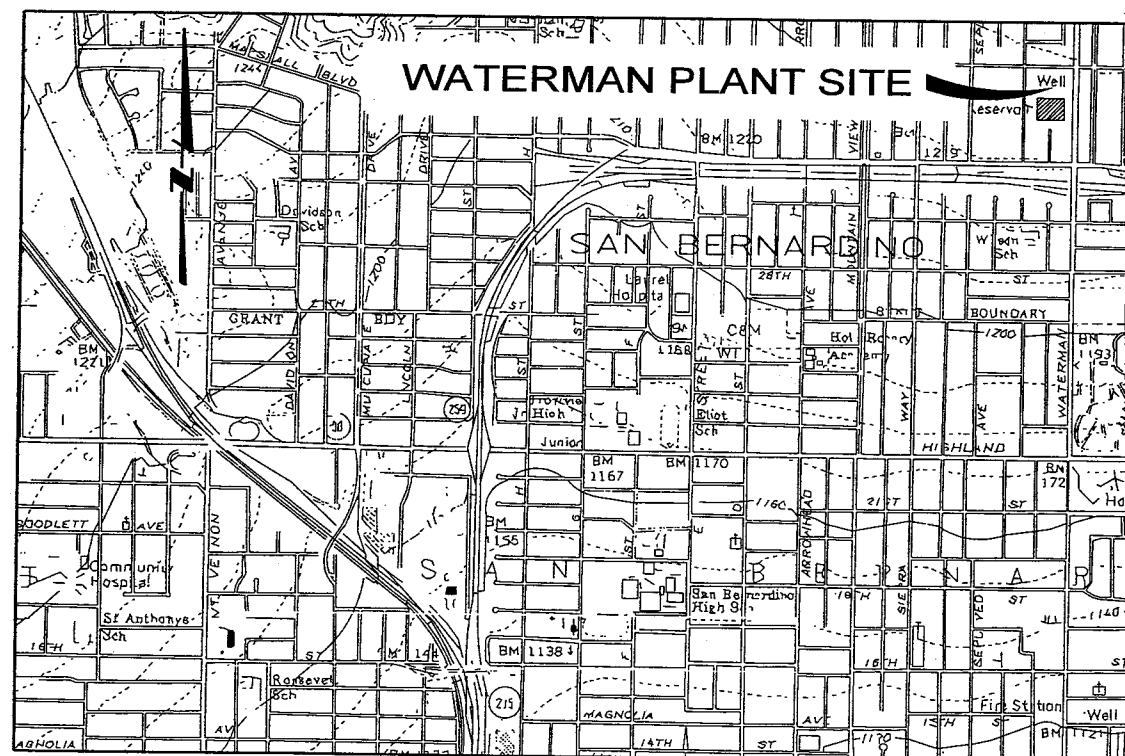

WATERMAN (SOUTH) PLANT
LOCATION MAP

"RECORD DRAWING"

NO.	DATE	DESCRIPTION	NO.	DATE	DESCRIPTION
11/98		RECORD DRAWING			
REVISIONS					

DESIGNED BY: PS
DRAWN BY: NDH
CHECKED BY: DHD

URS URS Consultants, Inc.
CONSULTING ENGINEERS
SACRAMENTO CALIFORNIA

JOB No. 62370



NEWMARK OU REMEDIAL DESIGN
NEWMARK GROUNDWATER
CONTAMINATION SUPERFUND SITE
NORTH & SOUTH PLANTS

VICINITY AND
LOCATION MAPS

Scale: NONE Date: 6/97 Dwg. No.: G-3

PIPE LINE SYMBOL IDENTIFICATION

PROCESS LINE
NON-PROCESS LINE OR UTILITY LINE

VALVE SYMBOLS

	CLV	CONTROL VALVE
	GV	GATE VALVE
	BFV	BUTTERFLY VALVE
	PCV	PLUG COCK VALVE
	GLV	GLOBE VALVE
	BV	BALL VALVE
	TWV	THREE WAY VALVE
	FWV	FOUR WAY VALVE
	PIV	PINCH VALVE
	PV	PLUG VALVE
	CV	CHECK VALVE
	NV	NEEDLE VALVE
	AV	ANGLE VALVE
	VPR	VACUUM/PRESSURE RELIEF
	VR	VACUUM RELIEF
	PR	PRESSURE RELIEF
	SGV	SLIDE GATE VALVE
	KGV	KNIFE GATE VALVE
	DV	DIAPHRAGM VALVE
	BFP	BACKFLOW PREVENTER
	PRV	PRESSURE REGULATING VALVE

PIPE FITTING SYMBOLS (USE FOR INSTALLATION OF ALL MATERIALS)

	THREADED FITTING
	FLANGED FITTING
	WELDED FITTING
	BELL & SPIGOT FITTING
	SOLVENT WELDED FITTING

PIPE LINE DESIGNATIONS

6"-CS-WM-1"
NORMAL LINE SIZE
MATERIAL
FLUID MEDIUM
INSULATION THICKNESS

MISCELLANEOUS PIPING COMPONENTS

	REDUCER (CONCENTRIC)
	REDUCER (ECCENTRIC)
	DOUBLE FLANGE
	DRAIN
	UNION
	ELBOW UP
	ELBOW DOWN
	PIPE CAP
	PIPE CAP (WELDED)
	RUPTURE DISK
	EXPANSION JOINT (METAL OR RUBBER)
	RUBBER SLEEVE
	Y-TYPE STRAINER W/PLUG
	Y-TYPE STRAINER W/VALVE
	HOSE CONNECTION
	QUICK DISCONNECT COUPLING (FEMALE)
	QUICK DISCONNECT COUPLING (MALE)
	TRAP

EQUIPMENT DESIGNATIONS

	CENTRIFUGAL PUMP
	CENTRIFUGAL FAN
	POSITIVE DISPLACEMENT PUMP
	ROTARY BLOWER
	AIR FILTER
	ROTARY LOBE PUMP

PIPING DESIGNATIONS

CI	-	CAST IRON
CS	-	CARBON STEEL
CU	-	COPPER TUBING
PVC	-	POLYVINYL CHLORIDE
PVC8	-	POLYVINYL CHLORIDE SCHEDULE 80
CPVC	-	CHLORINATED POLYVINYL CHLORIDE
SS	-	STAINLESS STEEL
GCS	-	GALVANIZED CARBON STEEL
LCS	-	LINED CARBON STEEL
FS	-	FLEXIBLE HOSE

ABBREVIATIONS

ATM	-	ATMOSPHERIC
BF	-	BLIND FLANGE
BOP	-	BOTTOM OF PIPE
CW	-	CHAINWHEEL OPERATED
DR.	-	DRAIN
F	-	FITTING
FC	-	FAIL CLOSED
FI	-	FAIL INDETERMINATE
FO	-	FAIL OPEN
GO	-	GEAR OPERATED
H.C.	-	HOSE CONNECTION
H. PT	-	HIGH POINT
IAS	-	INSTRUMENT AIR SUPPLY
L. PT	-	LOW POINT
NC	-	NORMALLY CLOSED
NLL	-	NORMAL LIQUID LEVEL
NO	-	NORMALLY OPEN
P	-	PIPE
P.O.S.	-	POINT OF SUPPORT
RO	-	RESTRICTION ORIFICE
S.T.	-	SAMPLE TAP
V	-	VALVE
V.S.	-	VENDOR SUPPLIED ITEM
XJ	-	EXPANSION JOINT

FLUID MEDIUM SPECIFICATIONS TABLE

FLUID MEDIUM ABBREVIATIONS	FLUID MEDIUM
RW	RAW WATER
TW	TREATED WATER
BW	BACKWASH WATER
SBW	SPENT BACKWASH WATER

INSTRUMENTATION SYMBOLS & LEGEND

	MOTOR
	PANEL LIGHT/INDICATOR

(INSTRUMENTATION)

F1 223 2 02
SERIES FUNCTIONAL GROUP

(EQUIPMENT)

P 02
TYPE FUNCTIONAL GROUP

INSTRUMENTATION SYMBOLS & LEGEND continued

GENERAL SYMBOL - BALLOON (APPROX. SIZE 1/16" DIA.)

LOCALLY MOUNTED	PE 1021	MOUNTED ON BOARD	PE 1021
MOUNTED BEHIND BOARD	PE 1021	LOCALLY MOUNTED LONG TAG NUMBER	PE 1022-23
MOUNTED BEHIND BOARD IN AUX LOCATION	PE 1021	MOUNTED ON BOARD TWO MEASURED VARIABLES	PE 1021 PE 1022
LOCALLY MOUNTED TWO MEASURED VARIABLES	PE 1021 PE 1022		
MOUNTED BEHIND BOARD TWO MEASURED VARIABLES	PE 1021 PE 1022		
AUX LOCATION: NORMALLY ACCESSIBLE TO OPERATOR	PE 1021	INTERLOCK	I 1
		PROGRAMMABLE INTERLOCK	I 2

MEANINGS OF IDENTIFICATION LETTERING


LTR	FIRST LETTER		SUCCEEDING LETTER		
	MEASURED OR INITIATING VARIABLE	MODIFIER	READOUT OR PASSIVE FUNCTION	OUTPUT FUNCTION	MODIFIER
A	ANALYSIS	-	ALARM	-	-
B	BURNER FLAME	-	USERS CHOICE	-	-
C	CONDUCTIVITY (ELEC)	-	-	CONTROL 13	-
D	DENSITY (MASS) OR SPECIFIC GRAVITY	-	DIFFERENTIAL	-	-
E	VOLTAGE (EMF)	-	PRIMARY ELEMENT	-	-
F	FLOW RATE	RATIO (FRACTION)*	-	-	-
G	GAGING (DIMENSIONAL)	-	GLASS*	-	-
H	HAND (MANUALLY ACTIVATED)	-	ALARM	-	HIGH *
I	CURRENT (ELEC)	-	INDICATE	-	-
J	POWER	SCAN	-	-	-
K	TIME OR TIME - SCHEDULE	-	-	CONTROL STATION	-
L	LEVEL	-	LIGHT (PILOT)	-	LOW
M	MOISTURE OR HUMIDITY	-	-	-	MIDDLE OR INTERMEDIATE
N	USERS CHOICE*	-	-	-	-
O	USERS CHOICE*	-	ORIFICE (RESTRICTION)	-	-
P	PRESSURE/VACUUM	-	POINT (TEST CONNECTION)	-	-
Q	QUANTITY/EVENT	INTEGRATE OR TOTALIZE*	-	-	-
R	RADIOACTIVITY	-	RECORD/PRINT	-	-
S	SPEED/FREQUENCY	SAFETY*	-	SWITCH*	-
T	TEMPERATURE	-	ALARM	TRANSMIT	-
U	MULTIVARIABLE*	-	MULTIFUNCTION	-	-
V	VISCOSITY	-	-	VALVE DAMPER OR LOUVER*	-
W	WEIGHT/FORCE	-	WELL	-	-
X	UNCLASSIFIED*	-	-	-	-
Y	USERS CHOICE*	-	ALARM	RELAY OR COMPUTE*	-
Z	POSITION	-	-	DRIVE, ACTUATE OR UNCLASSIFIED FINAL CONTROL ELEMENT	-

* = SEE ISA "INSTRUMENTATION SYMBOLS AND IDENTIFICATION" MANUAL (AMERICAN NATIONAL STANDARD) 1981 EDITION, TABLE 1, PAGE 12.


DPAH	=	DIFFERENTIAL PRESSURE ALARM (HIGH)
DPSL	=	DIFFERENTIAL PRESSURE SWITCH (LOW)
FE	=	FLOW ELEMENT
FSL	=	FLOW SWITCH (LOW)
FP	=	FLOW MEASURE
FIR	=	FLOW INDICATOR AND RECORDER
FI	=	FLOW INDICATOR
FOI	=	FLOW REGULATOR
LLA	=	LOW LEVEL ALARM
LC	=	LEVEL CONTROL
LSH	=	LEVEL SWITCH HIGH
LSL	=	LEVEL SWITCH LOW
LSHH	=	LEVEL SWITCH HIGH HIGH
PDSL	=	DIFFERENTIAL PRESSURE SWITCH
PI	=	PRESSURE INDICATOR (GAUGE)
PSL	=	PRESSURE SWITCH (LOW)
PSH	=	PRESSURE SWITCH (HIGH)
S	=	SAMPLE
TC	=	TEMPERATURE CONTROLLER
TE	=	TEMPERATURE ELEMENT
TI	=	TEMPERATURE INDICATOR (GAUGE)
TIR	=	TEMPERATURE INDICATOR AND RECORDER
TSL	=	TEMPERATURE SWITCH LOW
TSH	=	TEMPERATURE SWITCH HIGH
XIR	=	PH RECORDER
XSL	=	PH (LOW)
XSH	=	PH (HIGH)

SECTION & DETAIL IDENTIFICATION

SECTION CUTS

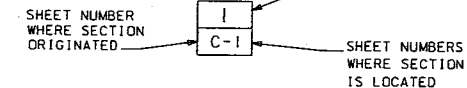

DETAIL CALL OUT

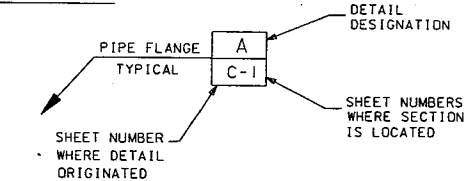

LOCAL SECTION/DETAIL CALL OUTS



"RECORD DRAWING"

LEGEND & SYMBOLS

Scale: NONE Date: 6/97 Dwg. No.: G-4

DESIGNED BY: NDH
DRAWN BY: NDH
CHECKED BY: DHD

URS URS Consultants, Inc.
CONSULTING ENGINEERS
SACRAMENTO CALIFORNIA




NEWMARK OU REMEDIAL DESIGN
NEWMARK GROUNDWATER
CONTAMINATION SUPERFUND SITE
NORTH & SOUTH PLANTS

JOB No. 62370

REVISIONS

NO.	DATE	DESCRIPTION	NO.	DATE	DESCRIPTION
11/98		RECORD DRAWING			

JOB No. 62370.50
PROJECT No. 1AUST5\PROJ\NEWMARK\ASBULT\IP-1.DGN

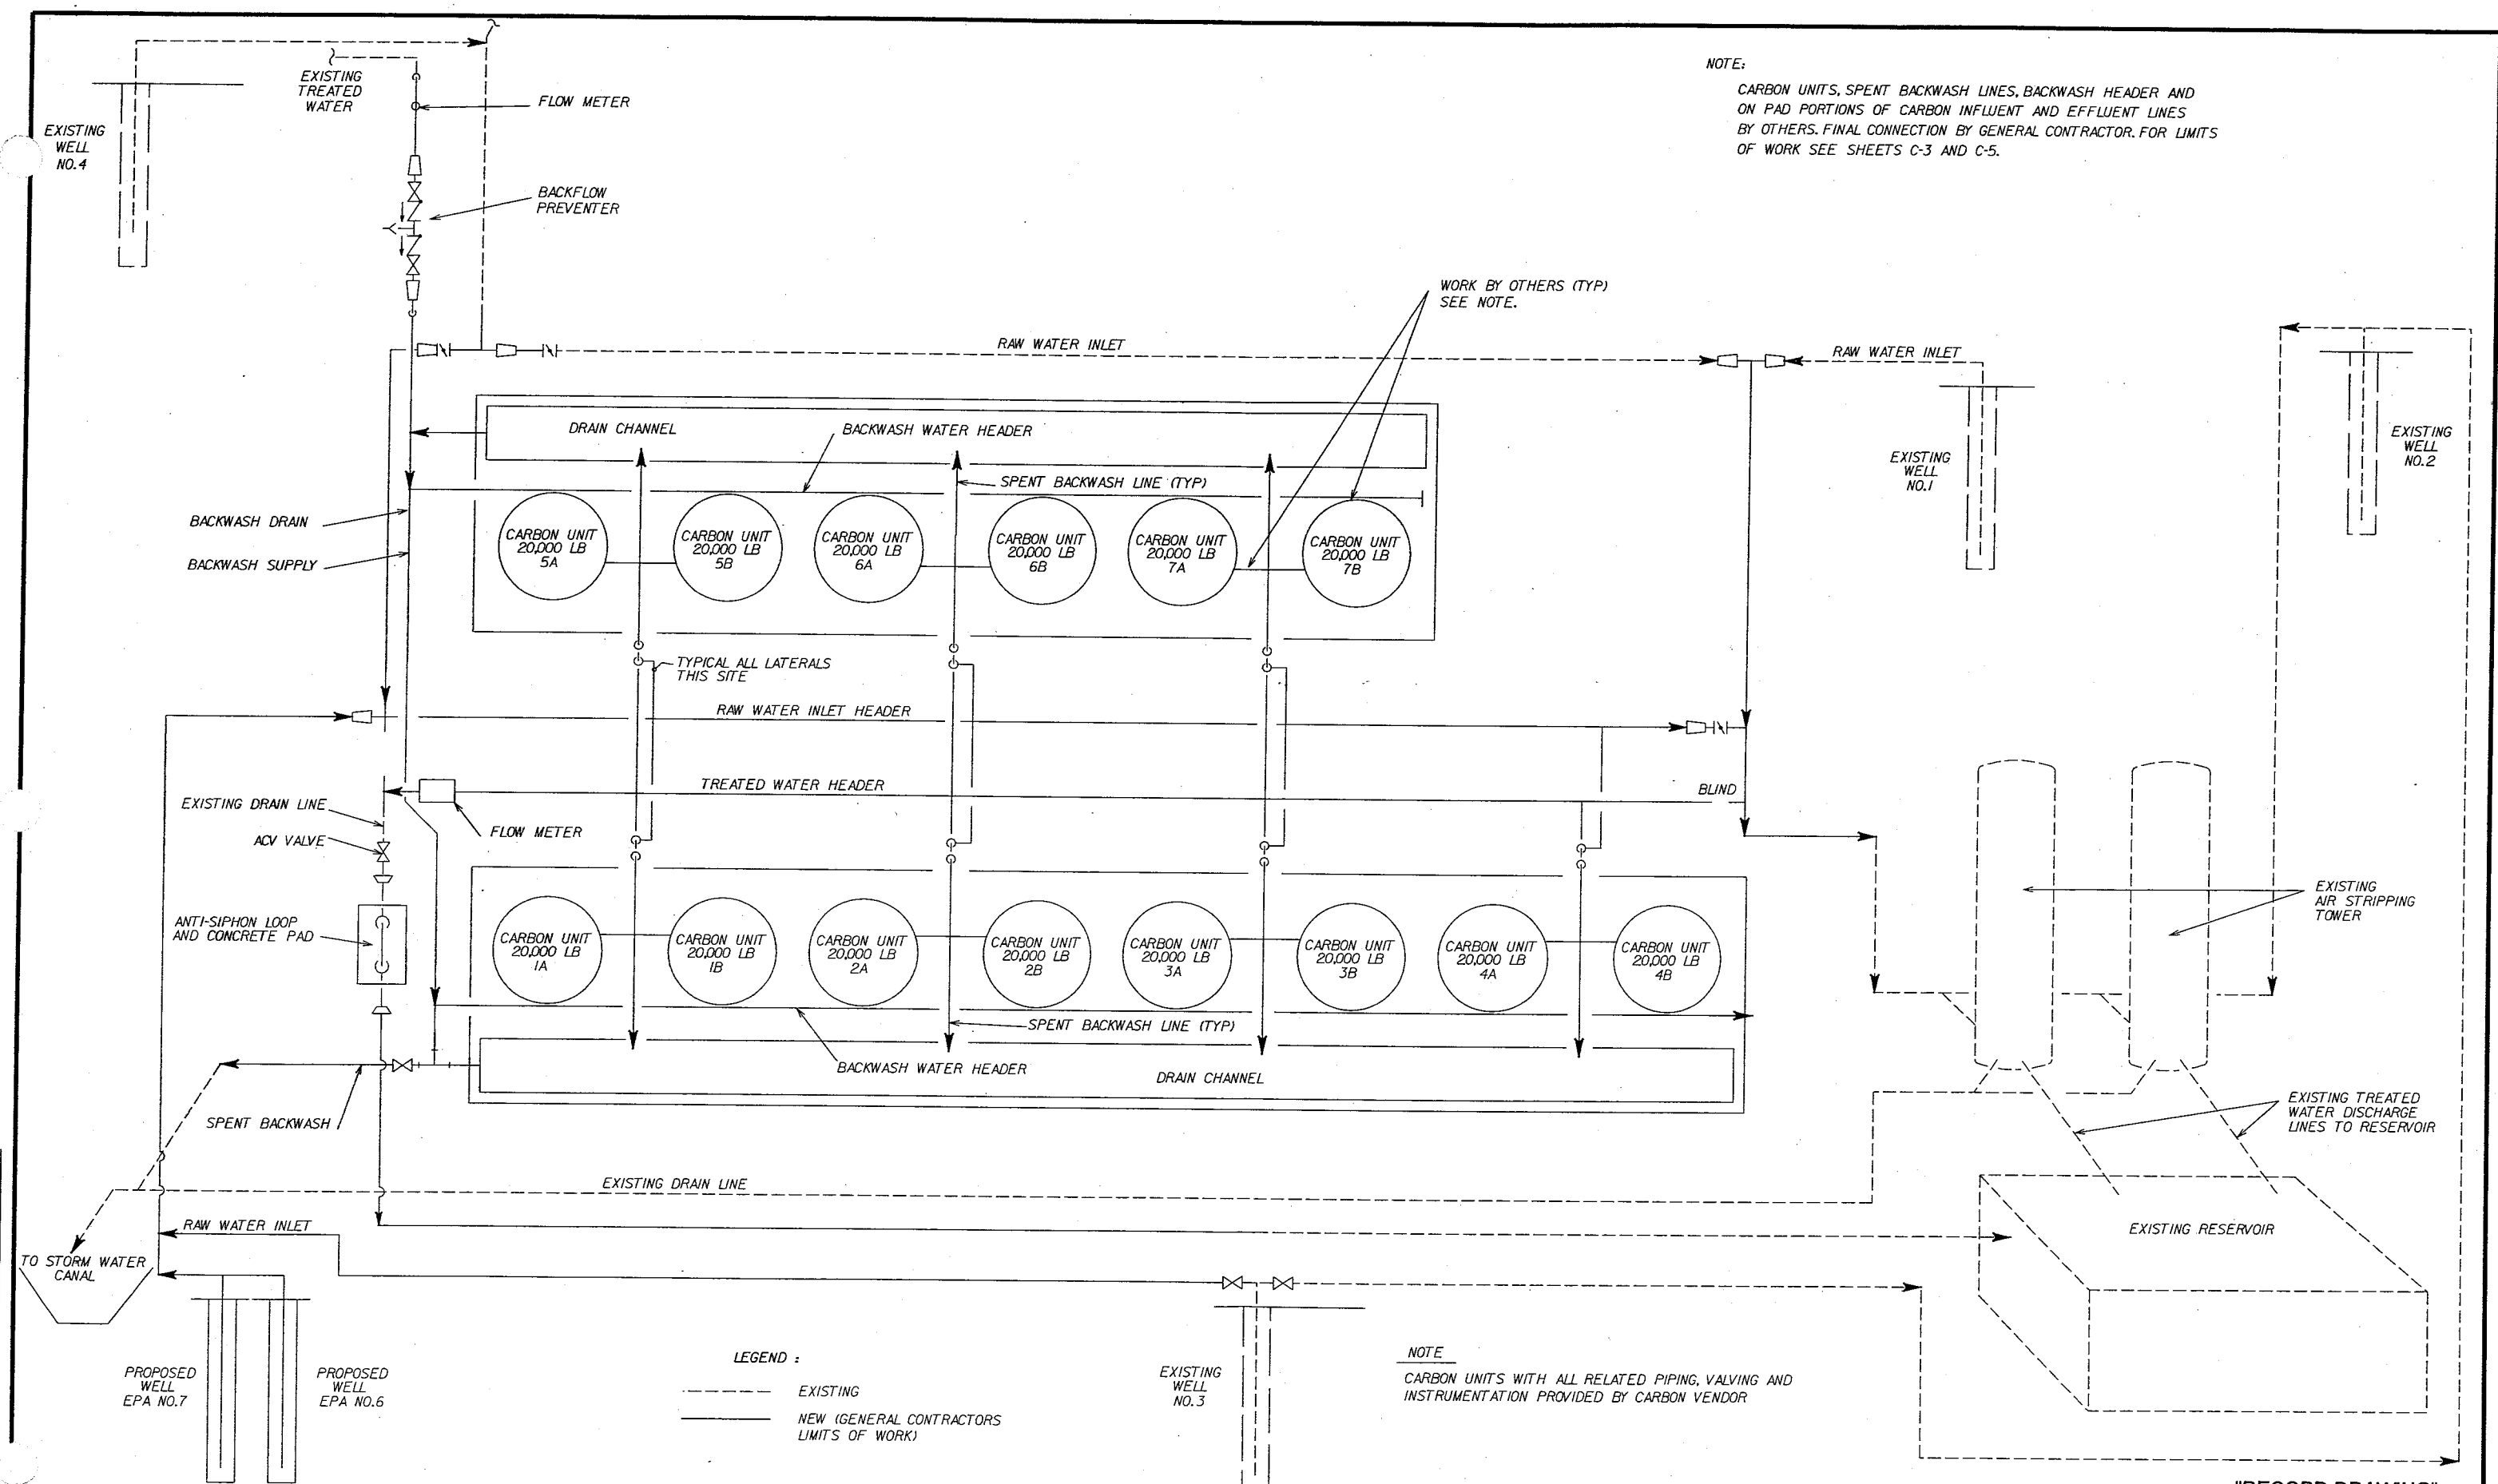


NO.	DATE	DESCRIPTION	NO.	DATE	DESCRIPTION

DESIGNED BY: PS
DRAWN BY: NDH
CHECKED BY: DHD

URS
URS Consultants, Inc.
CONSULTING ENGINEERS
SACRAMENTO CALIFORNIA

JOB No. 62370

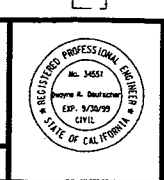


NEWMARK OU REMEDIAL DESIGN
NEWMARK GROUNDWATER
CONTAMINATION SUPERFUND SITE
NORTH & SOUTH PLANTS

"RECORD DRAWING"

**NORTH PLANT
PROCESS FLOW DIAGRAM**

Scale: NONE Date: 6/97 Dwg. No.: P-1

FOR CONTINUATION SEE SHEET P-2

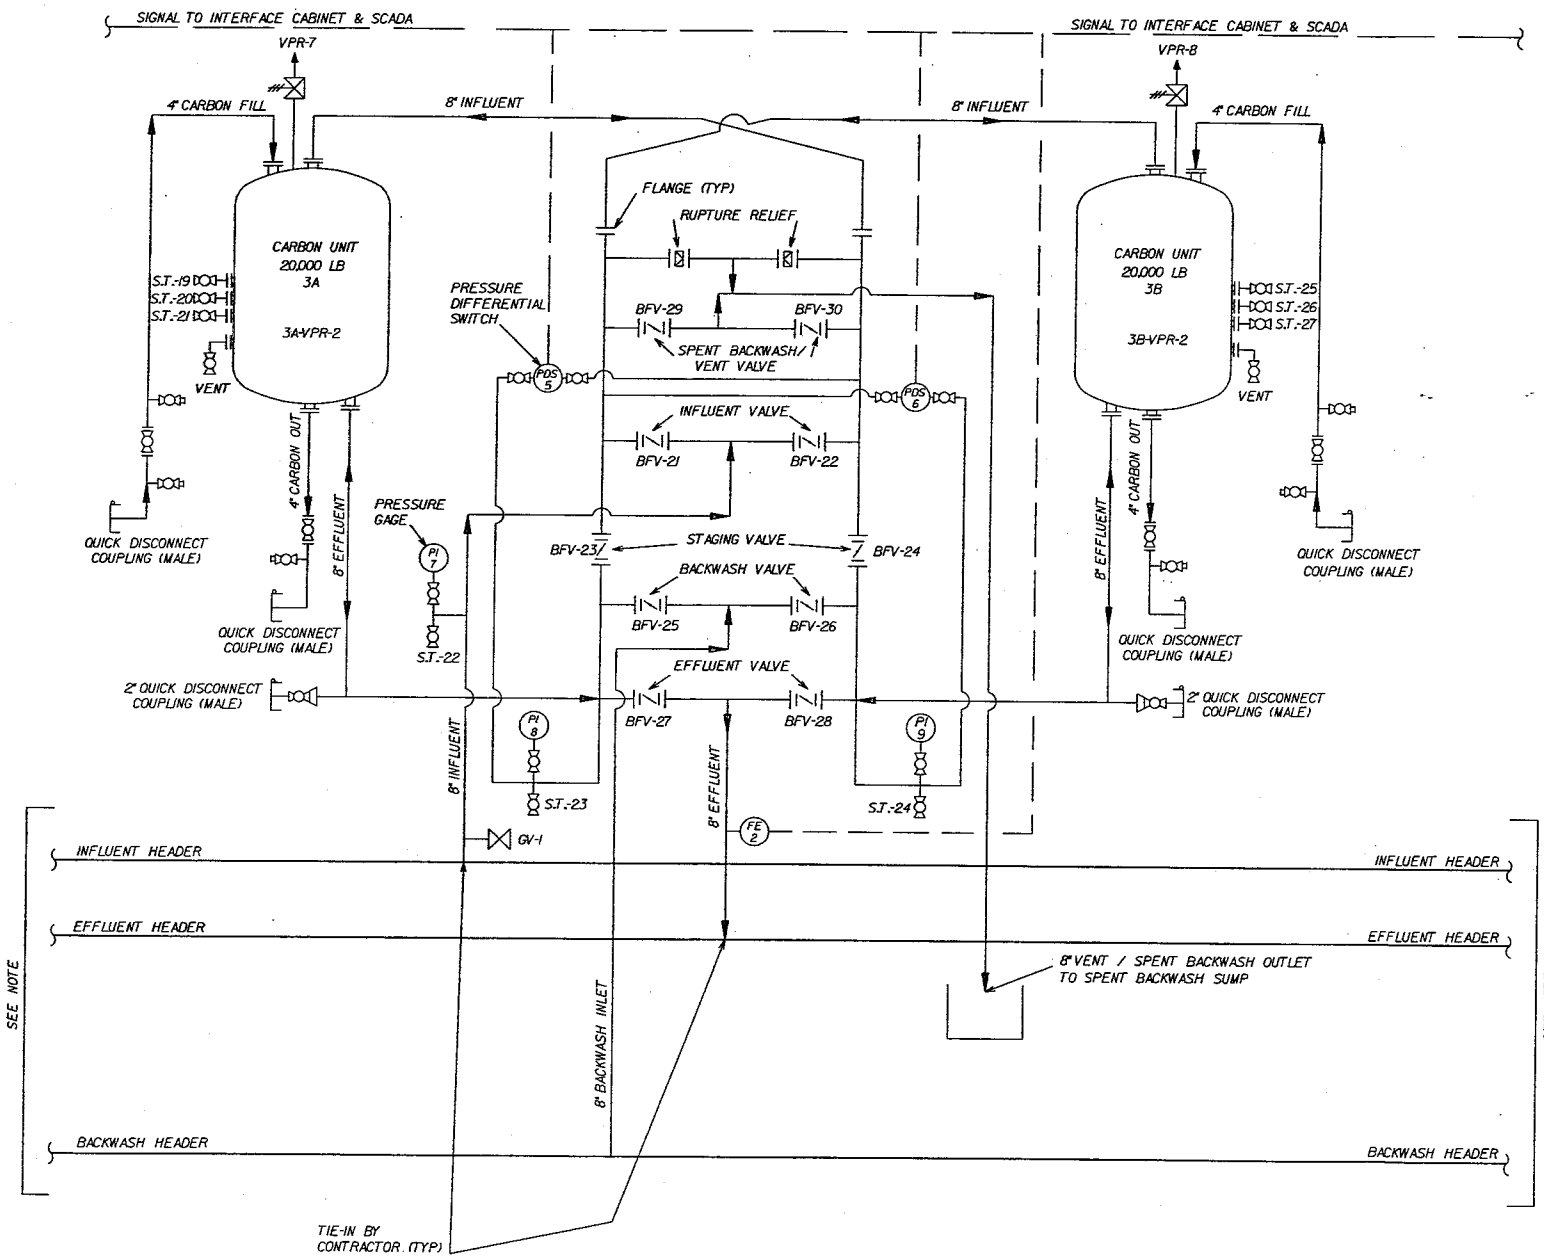

FOR CONTINUATION SEE SHEET P-4

NOTE :
FOR CONTINUATION SEE SHEETS C-3, P-1, P-2 AND P-4


"RECORD DRAWING"

[illegible]

DESIGNED BY: PS
DRAWN BY: NDH
CHECKED BY: DHD

URS URS Consultants, Inc.
CONSULTING ENGINEERS
SACRAMENTO CALIFORNIA

JOB No. 62370

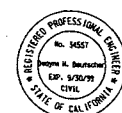

NEWMARK OU REMEDIAL DESIGN
NEWMARK GROUNDWATER
CONTAMINATION SUPERFUND SITE
NORTH & SOUTH PLANTS


**NORTH PLANT
PIPING AND INSTRUMENTATION
DIAGRAM (P&ID)**

Scale: NO SCALE	Date: 6/97	Dwg. No.: P-3
--------------------	------------	---------------

JOB No. 62370.50 FILE No. T:\AUSTIN\PROJECTS\NEWARK\ASBULTY IP-4.DGN

FOR CONTINUATION SEE SHEET P-3

SEE NOTE

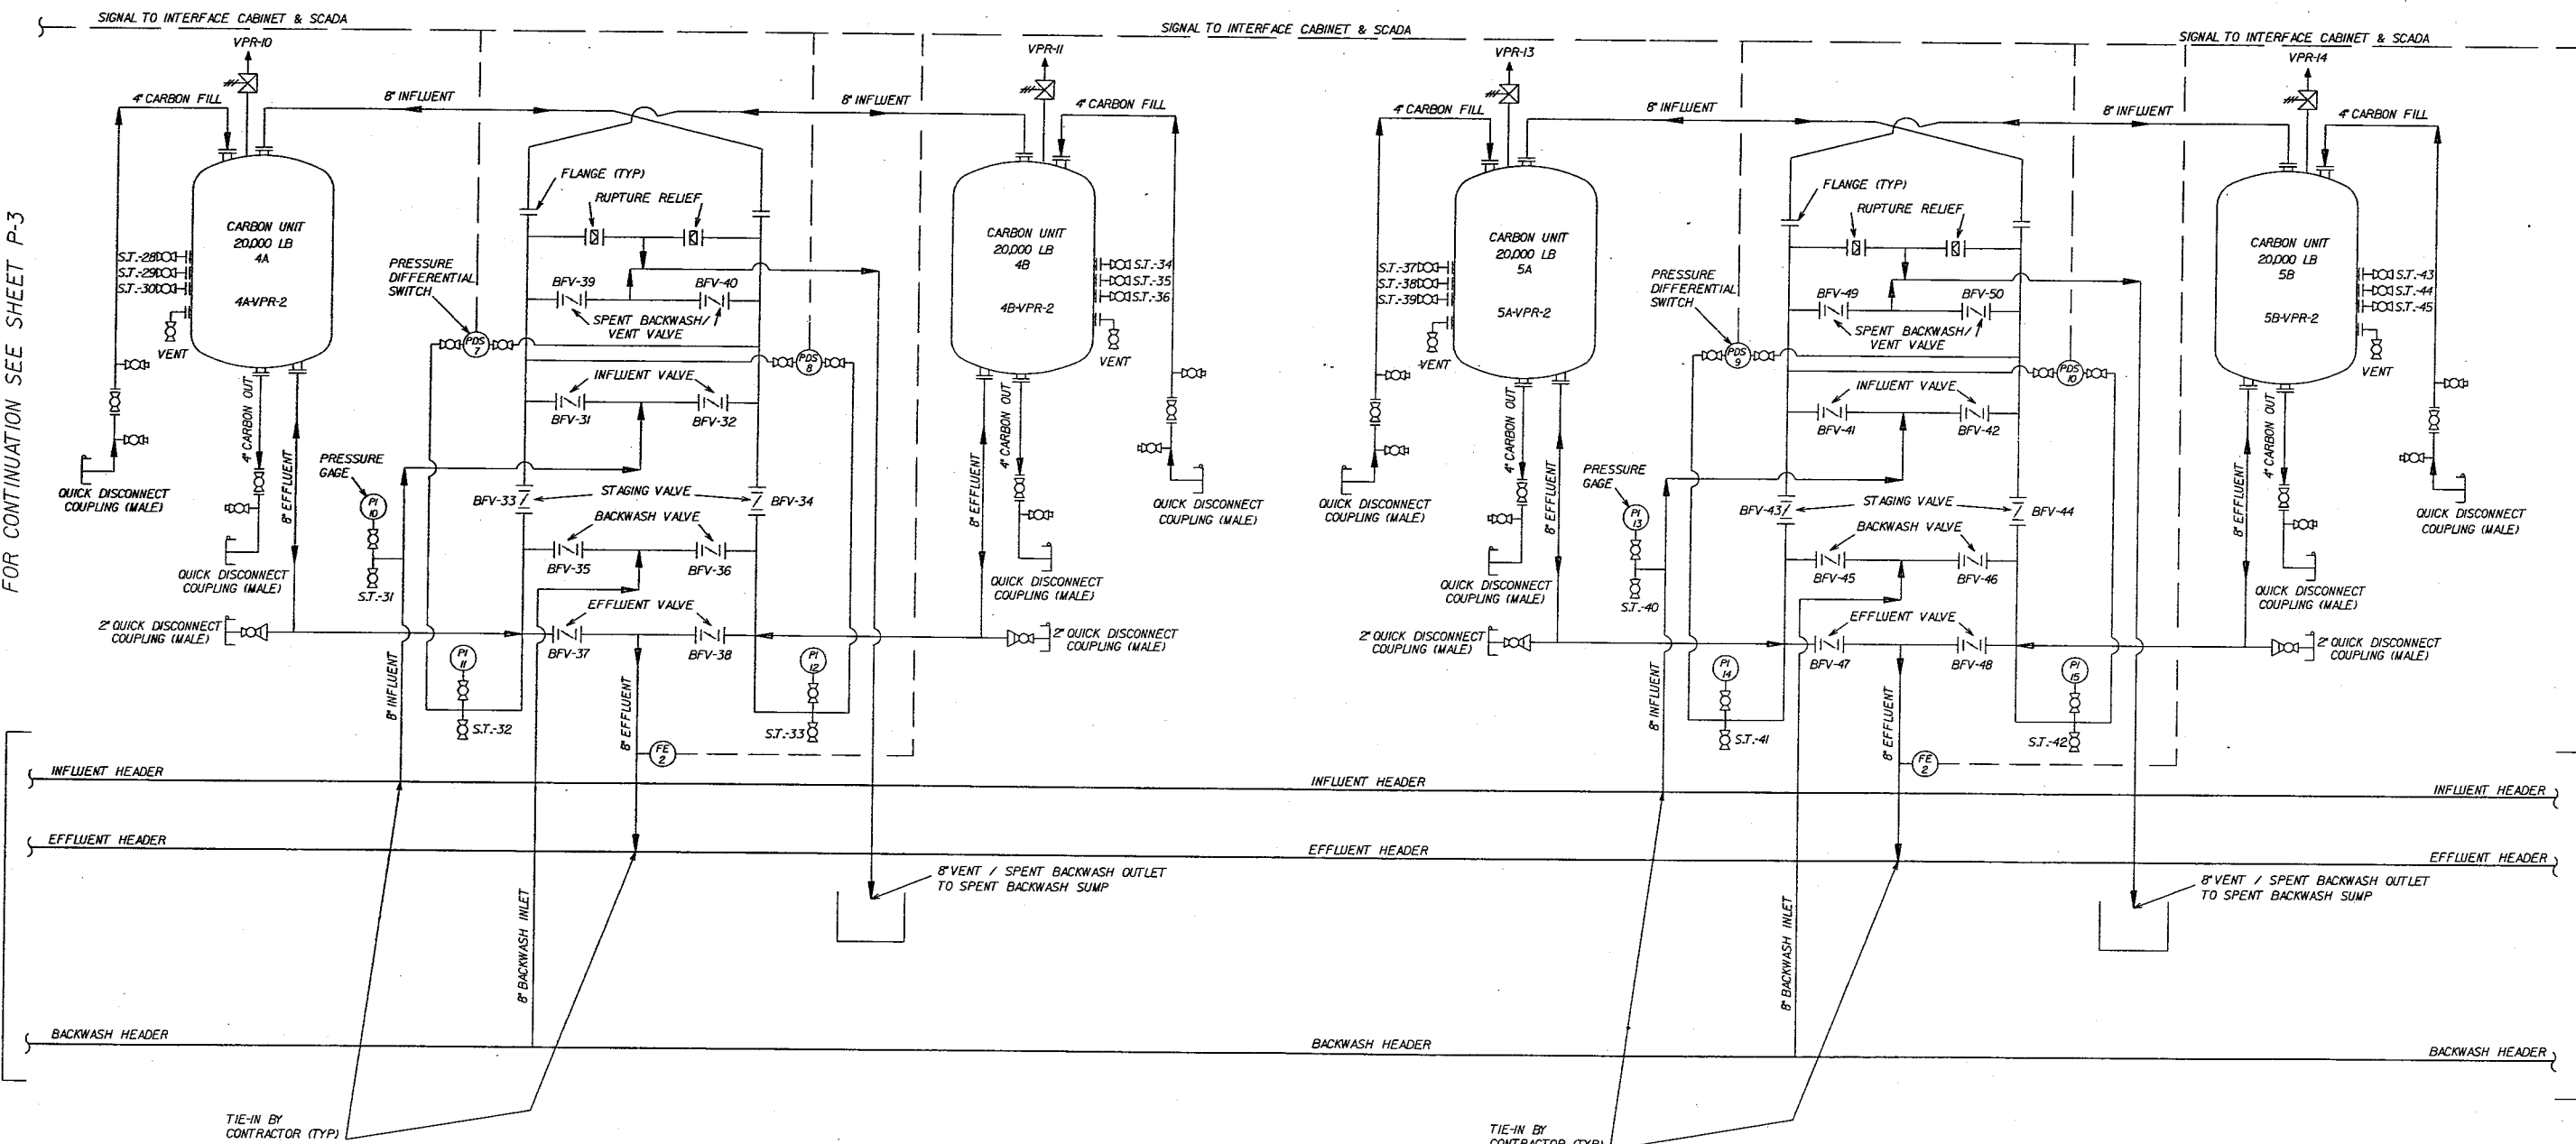

FOR CONTINUATION SEE SHEET P-5

SEE NOTE

NOTE:
FOR CONTINUATION SEE SHEETS C-3, P-1, P-3 AND P-5

NO.	DATE	DESCRIPTION	NO.	DATE	DESCRIPTION
11/98		RECORD DRAWING			
REVISIONS					

DESIGNED BY: PS
DRAWN BY: NDH
CHECKED BY: DHD

URS URS Consultants, Inc.
CONSULTING ENGINEERS
SACRAMENTO CALIFORNIA

JOB No. 62370



NEWMARK OU REMEDIAL DESIGN
NEWMARK GROUNDWATER
CONTAMINATION SUPERFUND SITE
NORTH & SOUTH PLANTS

NORTH PLANT
PIPING AND INSTRUMENTATION
DIAGRAM (P&ID)

Scale: NO SCALE Date: 6/97 Dwg. No.: P-4


"RECORD DRAWING"

JOB No. 62370.50 FILE No. T:\JUST5\PROJ\NEWMARK\ASBUILT\IP-5.DGN

FOR CONTINUATION SEE SHEET P-4

SEE NOTE

SEE NOTE

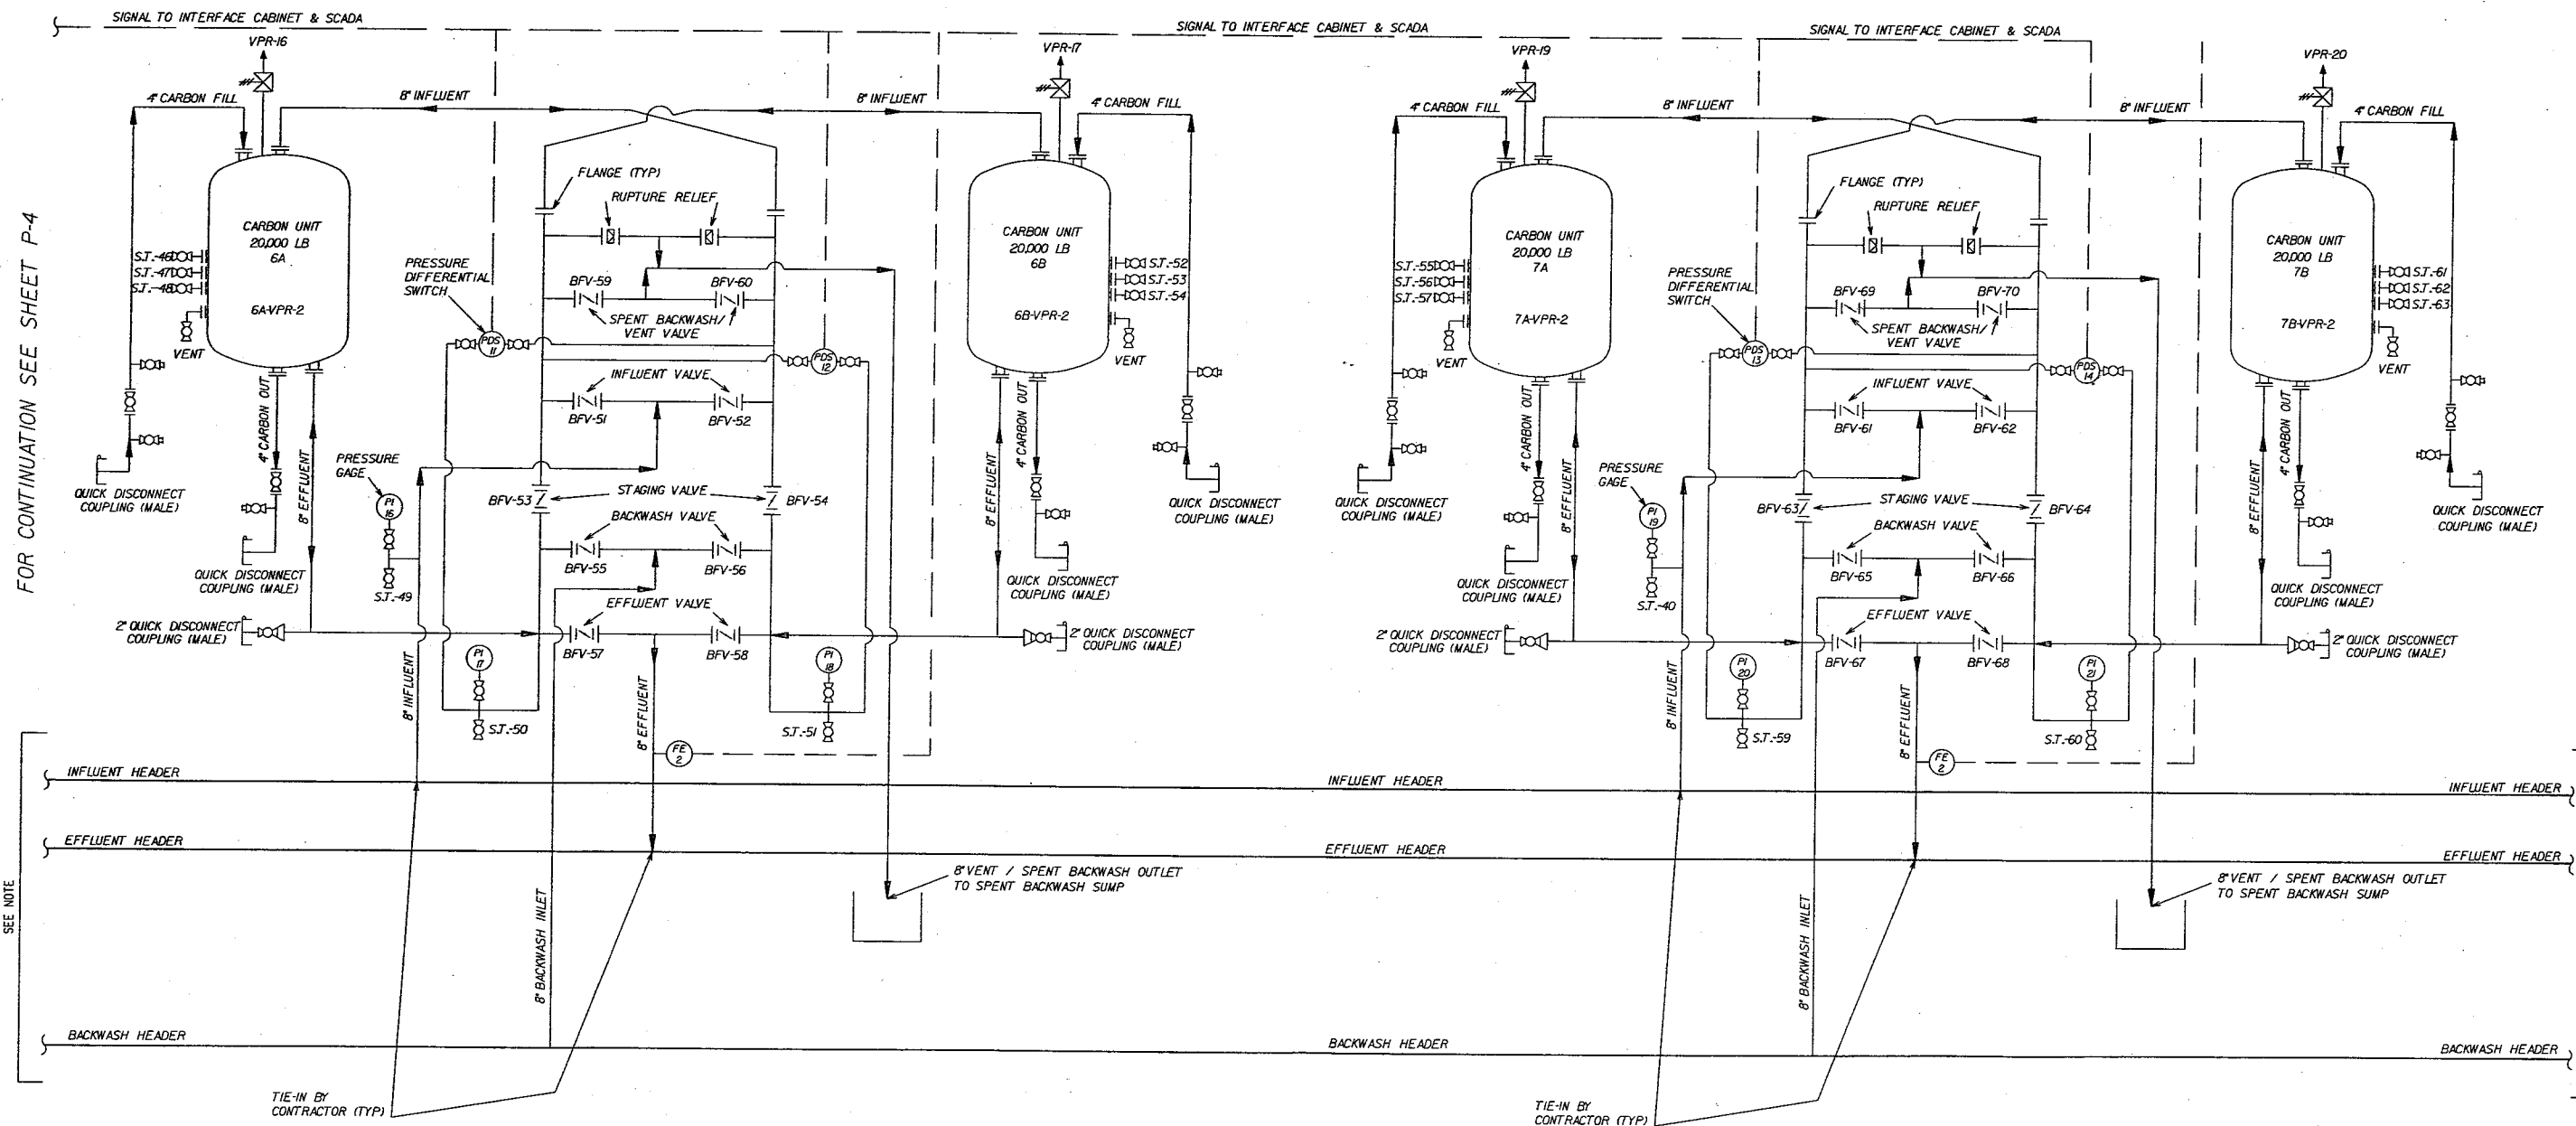

NOTE:
FOR CONTINUATION SEE SHEETS C-3, P-1 AND P-4

"RECORD DRAWING"

NO.	DATE	DESCRIPTION	NO.	DATE	DESCRIPTION
11/98		RECORD DRAWING			
REVISIONS					

DESIGNED BY: PS
DRAWN BY: NDH
CHECKED BY: DHD

URS URS Consultants, Inc.
CONSULTING ENGINEERS
SACRAMENTO CALIFORNIA

JOB No. 62370



NEWMARK OU REMEDIAL DESIGN
NEWMARK GROUNDWATER
CONTAMINATION SUPERFUND SITE
NORTH & SOUTH PLANTS

NORTH PLANT
PIPING AND INSTRUMENTATION
DIAGRAM (P&ID)



Scale: NO SCALE Date: 6/97 Dwg. No.: P-5

CARBON UNITS VALVE SCHEDULE

* NEW VALVE ADDED AFTER VESSEL INSTALLATION
NOTE : FOR THE OPERATION OF VALVES IN EACH OPERATING MODE REFER TO THE O&M MANUAL

LOCATION			LOCATION			LOCATION			LOCATION			LOCATION		
1A & 1B			2A & 2B			3A & 3B			4A & 4B			5A & 5B		
VALVE NO.	SERVICE	ASBUILT NO.	VALVE NO.	SERVICE	ASBUILT NO.	VALVE NO.	SERVICE	ASBUILT NO.	VALVE NO.	SERVICE	ASBUILT NO.	VALVE NO.	SERVICE	ASBUILT NO.
VPR-1	AIR VACUUM/PRESSURE RELIEF	1A-VPR-1	VPR-4	AIR VACUUM/PRESSURE RELIEF	2A-VPR-1	VPR-7	AIR VACUUM/PRESSURE RELIEF	3A-VPR-1	VPR-10	AIR VACUUM/PRESSURE RELIEF	4A-VPR-1	VPR-13	AIR VACUUM/PRESSURE RELIEF	5A-VPR-1
VPR-2	AIR VACUUM/PRESSURE RELIEF	1B-VPR-1	VPR-5	AIR VACUUM/PRESSURE RELIEF	2B-VPR-1	VPR-8	AIR VACUUM/PRESSURE RELIEF	3B-VPR-1	VPR-11	AIR VACUUM/PRESSURE RELIEF	4B-VPR-1	VPR-14	AIR VACUUM/PRESSURE RELIEF	5B-VPR-1
* 1A-VPR-2	AIR VACUUM/PRESSURE RELIEF	1A-VPR-2	* 2A-VPR-2	AIR VACUUM/PRESSURE RELIEF	2A-VPR-2	* 3A-VPR-2	AIR VACUUM/PRESSURE RELIEF	3A-VPR-2	* 4A-VPR-2	AIR VACUUM/PRESSURE RELIEF	4A-VPR-2	* 5A-VPR-2	AIR VACUUM/PRESSURE RELIEF	5A-VPR-2
* 1B-VPR-2	AIR VACUUM/PRESSURE RELIEF	1B-VPR-2	* 2B-VPR-2	AIR VACUUM/PRESSURE RELIEF	2B-VPR-2	* 3B-VPR-2	AIR VACUUM/PRESSURE RELIEF	3B-VPR-2	* 4B-VPR-2	AIR VACUUM/PRESSURE RELIEF	4B-VPR-2	* 5B-VPR-2	AIR VACUUM/PRESSURE RELIEF	5B-VPR-2
SJ-1	SAMPLE TAP CARBON UNIT 1A	1A-ST-1	SJ-10	SAMPLE TAP CARBON UNIT 2A	2A-ST-1	SJ-19	SAMPLE TAP CARBON UNIT 3A	3A-ST-1	SJ-28	SAMPLE TAP CARBON UNIT 4A	4A-ST-1	SJ-37	SAMPLE TAP CARBON UNIT 5A	5A-ST-1
SJ-2	SAMPLE TAP CARBON UNIT 1A	1A-ST-2	SJ-11	SAMPLE TAP CARBON UNIT 2A	2A-ST-2	SJ-20	SAMPLE TAP CARBON UNIT 3A	3A-ST-2	SJ-29	SAMPLE TAP CARBON UNIT 4A	4A-ST-2	SJ-38	SAMPLE TAP CARBON UNIT 5A	5A-ST-2
SJ-3	SAMPLE TAP CARBON UNIT 1A	1A-ST-3	SJ-12	SAMPLE TAP CARBON UNIT 2A	2A-ST-3	SJ-21	SAMPLE TAP CARBON UNIT 3A	3A-ST-3	SJ-30	SAMPLE TAP CARBON UNIT 4A	4A-ST-3	SJ-39	SAMPLE TAP CARBON UNIT 5A	5A-ST-3
SJ-4	SAMPLE TAP INFLUENT	1A-ST-4	SJ-13	SAMPLE TAP INFLUENT	2A-ST-4	SJ-22	SAMPLE TAP INFLUENT	3A-ST-4	SJ-31	SAMPLE TAP INFLUENT	4A-ST-4	SJ-40	SAMPLE TAP INFLUENT	5A-ST-4
SJ-5	SAMPLE TAP INTERMEDIATE	1A-ST-5,1B-ST-5	SJ-14	SAMPLE TAP INTERMEDIATE	2A-ST-5,2B-ST-5	SJ-23	SAMPLE TAP INTERMEDIATE	3A-ST-5,3B-ST-5	SJ-32	SAMPLE TAP INTERMEDIATE	4A-ST-5,4B-ST-5	SJ-41	SAMPLE TAP INTERMEDIATE	5A-ST-5,5B-ST-5
SJ-6	SAMPLE TAP EFFLUENT	1B-ST-4	SJ-15	SAMPLE TAP EFFLUENT	2B-ST-4	SJ-24	SAMPLE TAP EFFLUENT	3B-ST-4	SJ-33	SAMPLE TAP EFFLUENT	4B-ST-4	SJ-42	SAMPLE TAP EFFLUENT	5B-ST-4
SJ-7	SAMPLE TAP CARBON UNIT 1B	1B-ST-1	SJ-16	SAMPLE TAP CARBON UNIT 2B	2B-ST-1	SJ-25	SAMPLE TAP CARBON UNIT 3B	3B-ST-1	SJ-34	SAMPLE TAP CARBON UNIT 4B	4B-ST-1	SJ-43	SAMPLE TAP CARBON UNIT 5B	5B-ST-1
SJ-8	SAMPLE TAP CARBON UNIT 1B	1B-ST-2	SJ-17	SAMPLE TAP CARBON UNIT 2B	2B-ST-2	SJ-26	SAMPLE TAP CARBON UNIT 3B	3B-ST-2	SJ-35	SAMPLE TAP CARBON UNIT 4B	4B-ST-2	SJ-44	SAMPLE TAP CARBON UNIT 5B	5B-ST-2
SJ-9	SAMPLE TAP CARBON UNIT 1B	1B-ST-3	SJ-18	SAMPLE TAP CARBON UNIT 2B	2B-ST-3	SJ-27	SAMPLE TAP CARBON UNIT 3B	3B-ST-3	SJ-36	SAMPLE TAP CARBON UNIT 4B	4B-ST-3	SJ-45	SAMPLE TAP CARBON UNIT 5B	5B-ST-3
BFV-1	INFLUENT	1A-BFV-2	BFV-11	INFLUENT	2A-BFV-2	BFV-21	INFLUENT	3A-BFV-2	BFV-31	INFLUENT	4A-BFV-2	BFV-41	INFLUENT	5A-BFV-2
BFV-2	INFLUENT	1B-BFV-2	BFV-12	INFLUENT	2B-BFV-2	BFV-22	INFLUENT	3B-BFV-2	BFV-32	INFLUENT	4B-BFV-2	BFV-42	INFLUENT	5B-BFV-2
BFV-3	STAGING	1A-BFV-3	BFV-13	STAGING	2A-BFV-3	BFV-23	STAGING	3A-BFV-3	BFV-33	STAGING	4A-BFV-3	BFV-43	STAGING	5A-BFV-3
BFV-4	STAGING	1B-BFV-3	BFV-14	STAGING	2B-BFV-3	BFV-24	STAGING	3B-BFV-3	BFV-34	STAGING	4B-BFV-3	BFV-44	STAGING	5B-BFV-3
BFV-5	BACKWASH	1A-BFV-4	BFV-15	BACKWASH	2A-BFV-4	BFV-25	BACKWASH	3A-BFV-4	BFV-35	BACKWASH	4A-BFV-4	BFV-45	BACKWASH	5A-BFV-4
BFV-6	BACKWASH	1B-BFV-4	BFV-16	BACKWASH	2B-BFV-4	BFV-26	BACKWASH	3B-BFV-4	BFV-36	BACKWASH	4B-BFV-4	BFV-46	BACKWASH	5B-BFV-4
BFV-7	EFFLUENT	1A-BFV-5	BFV-17	EFFLUENT	2A-BFV-5	BFV-27	EFFLUENT	3A-BFV-5	BFV-37	EFFLUENT	4A-BFV-5	BFV-47	EFFLUENT	5A-BFV-5
BFV-8	EFFLUENT	1B-BFV-5	BFV-18	EFFLUENT	2B-BFV-5	BFV-28	EFFLUENT	3B-BFV-5	BFV-38	EFFLUENT	4B-BFV-5	BFV-48	EFFLUENT	5B-BFV-5
BFV-9	SPENT BACKWASH/VENT	1A-BFV-1	BFV-19	SPENT BACKWASH/VENT	2A-BFV-1	BFV-29	SPENT BACKWASH/VENT	3A-BFV-1	BFV-39	SPENT BACKWASH/VENT	4A-BFV-1	BFV-49	SPENT BACKWASH/VENT	5A-BFV-1
BFV-10	SPENT BACKWASH/VENT	1B-BFV-1	BFV-20	SPENT BACKWASH/VENT	2B-BFV-1	BFV-30	SPENT BACKWASH/VENT	3B-BFV-1	BFV-40	SPENT BACKWASH/VENT	4B-BFV-1	BFV-50	SPENT BACKWASH/VENT	5B-BFV-1

LOCATION			LOCATION		
6A & 6B			7A & 7B		
VALVE NO.	SERVICE	ASBUILT NO.	VALVE NO.	SERVICE	ASBUILT NO.
VPR-16	AIR VACUUM/PRESSURE RELIEF	6A-VPR-1	VPR-19	AIR VACUUM/PRESSURE RELIEF	7A-VPR-1
VPR-17	AIR VACUUM/PRESSURE RELIEF	6B-VPR-1	VPR-20	AIR VACUUM/PRESSURE RELIEF	7B-VPR-1
* 6A-VPR-2	AIR VACUUM/PRESSURE RELIEF	6A-VPR-2	* 7A-VPR-2	AIR VACUUM/PRESSURE RELIEF	7A-VPR-2
* 6B-VPR-2	AIR VACUUM/PRESSURE RELIEF	6B-VPR-2	* 7B-VPR-2	AIR VACUUM/PRESSURE RELIEF	7B-VPR-2
SJ-46	SAMPLE TAP CARBON UNIT 6A	6A-ST-1	SJ-55	SAMPLE TAP CARBON UNIT 7A	7A-ST-1
SJ-47	SAMPLE TAP CARBON UNIT 6A	6A-ST-2	SJ-56	SAMPLE TAP CARBON UNIT 7A	7A-ST-2
SJ-48	SAMPLE TAP CARBON UNIT 6A	6A-ST-3	SJ-57	SAMPLE TAP CARBON UNIT 7A	7A-ST-3
SJ-49	SAMPLE TAP INFLUENT	6A-ST-4	SJ-58	SAMPLE TAP INFLUENT	7A-ST-4
SJ-50	SAMPLE TAP INTERMEDIATE	6A-ST-5,6B-ST-5	SJ-59	SAMPLE TAP INTERMEDIATE	7A-ST-5,7B-ST-5
SJ-51	SAMPLE TAP EFFLUENT	6B-ST-4	SJ-60	SAMPLE TAP EFFLUENT	7B-ST-4
SJ-52	SAMPLE TAP CARBON UNIT 6B	6B-ST-1	SJ-61	SAMPLE TAP CARBON UNIT 7B	7B-ST-1
SJ-53	SAMPLE TAP CARBON UNIT 6B	6B-ST-2	SJ-62	SAMPLE TAP CARBON UNIT 7B	7B-ST-2
SJ-54	SAMPLE TAP CARBON UNIT 6B	6B-ST-3	SJ-63	SAMPLE TAP CARBON UNIT 7B	7B-ST-3
BFV-51	INFLUENT	6A-BFV-2	BFV-61	INFLUENT	7A-BFV-2
BFV-52	INFLUENT	6B-BFV-2	BFV-62	INFLUENT	7B-BFV-2
BFV-53	STAGING	6A-BFV-3	BFV-63	STAGING	7A-BFV-3
BFV-54	STAGING	6B-BFV-3	BFV-64	STAGING	7B-BFV-3
BFV-55	BACKWASH	6A-BFV-4	BFV-65	BACKWASH	7A-BFV-4
BFV-56	BACKWASH	6B-BFV-4	BFV-66	BACKWASH	7B-BFV-4
BFV-57	EFFLUENT	6A-BFV-5	BFV-67	EFFLUENT	7A-BFV-5
BFV-58	EFFLUENT	6B-BFV-5	BFV-68	EFFLUENT	7B-BFV-5
BFV-59	SPENT BACKWASH/VENT	6A-BFV-1	BFV-69	SPENT BACKWASH/VENT	7A-BFV-1
BFV-60	SPENT BACKWASH/VENT	6B-BFV-1	BFV-70	SPENT BACKWASH/VENT	7B-BFV-1


DESIGNED BY: PS				NEWMARK OU REMEDIAL DESIGN NEWMARK GROUNDWATER CONTAMINATION SUPERFUND SITE NORTH & SOUTH PLANTS	NORTH PLANT CARBON UNITS VALVE SCHEDULE		
DRAWN BY: NDH					Scale: NO SCALE	Date: 6/97	Dwg. No.: P-6
CHECKED BY: DHD							

REVISIONS							
NO.	DATE	DESCRIPTION		NO.	DATE	DESCRIPTION	
11/98		RECORD DRAWING					

JOB No. 62370

"RECORD DRAWING"

JOB NO. 62370.60
T:\AUSTIN\PROJECTS\NEWARK\ASBUILT\IP-7.DGN

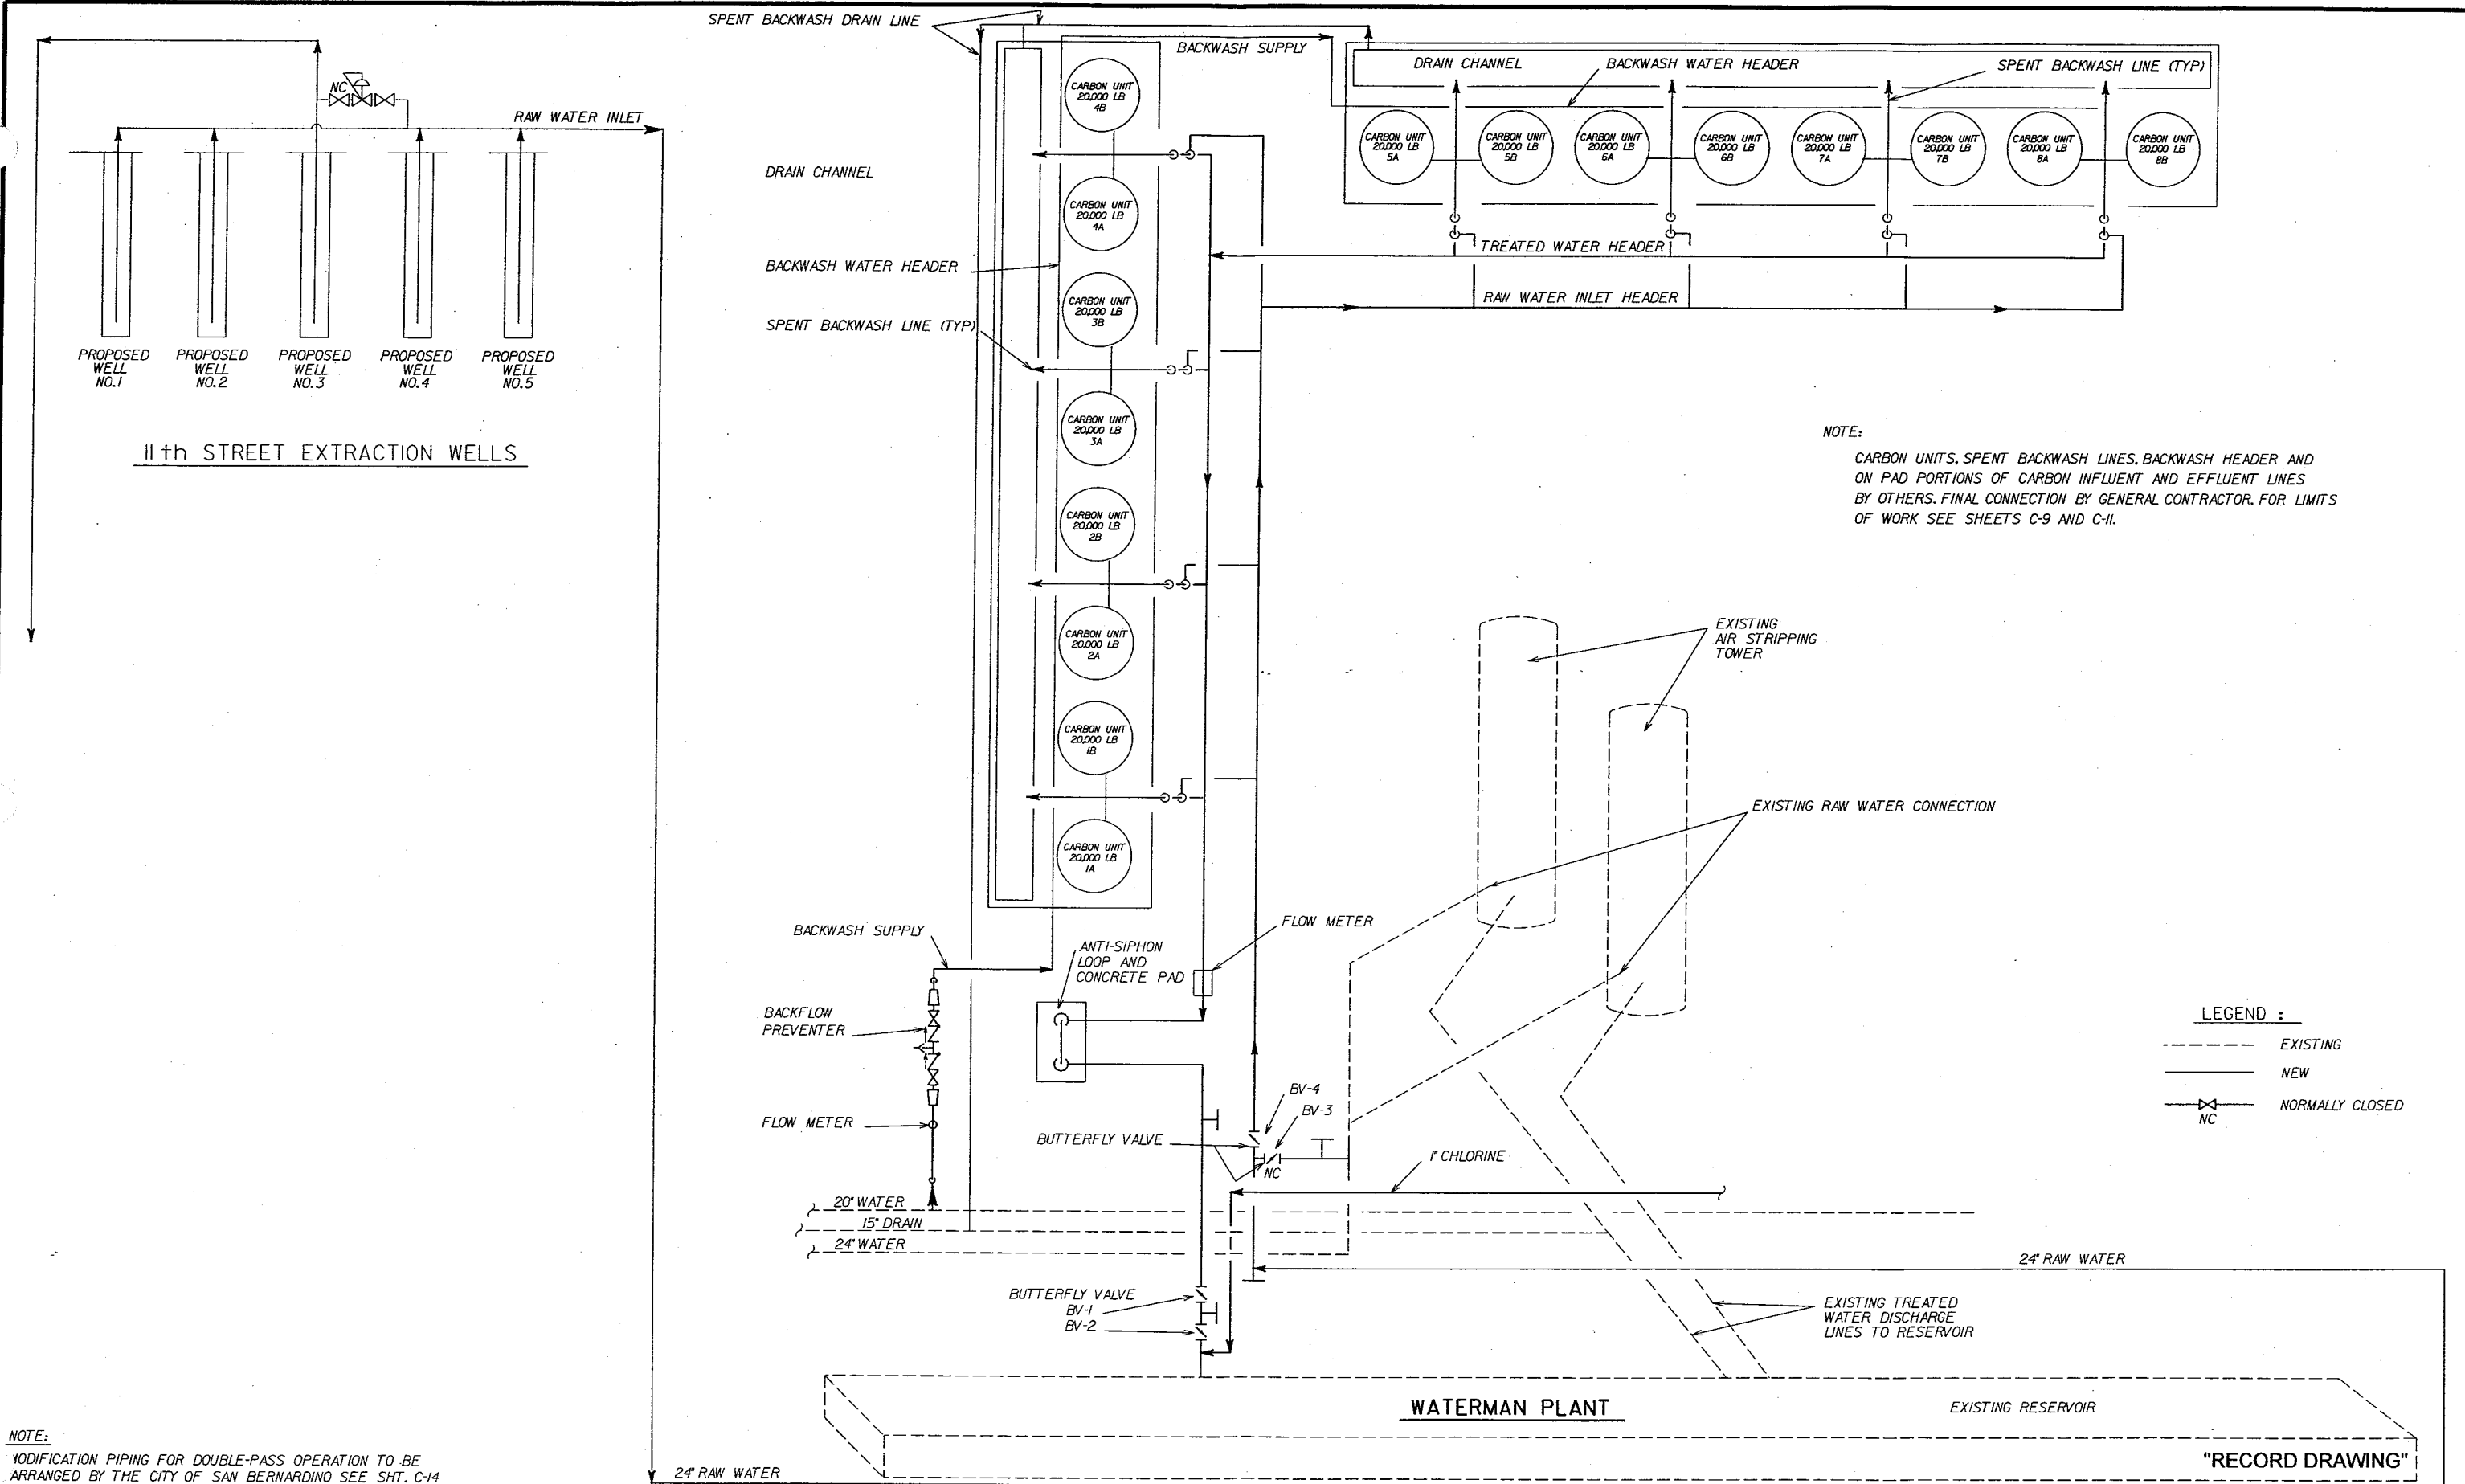

DESIGNED BY: PS
DRAWN BY: NDH
CHECKED BY: DHD

URS URS Consultants, Inc.
CONSULTING ENGINEERS
SACRAMENTO CALIFORNIA




JOB No. 62370

NEWMARK OU REMEDIAL DESIGN
NEWMARK GROUNDWATER
CONTAMINATION SUPERFUND SITE
NORTH & SOUTH PLANTS

WATERMAN PLANT
PROCESS FLOW DIAGRAM

Scale: NONE Date: 6/97 Dwg. No.: P-7

JOB No. 62370.60 FILE No. T:\JUST5\PROJ\NEWARK\ASBULT\IP-8.DGN

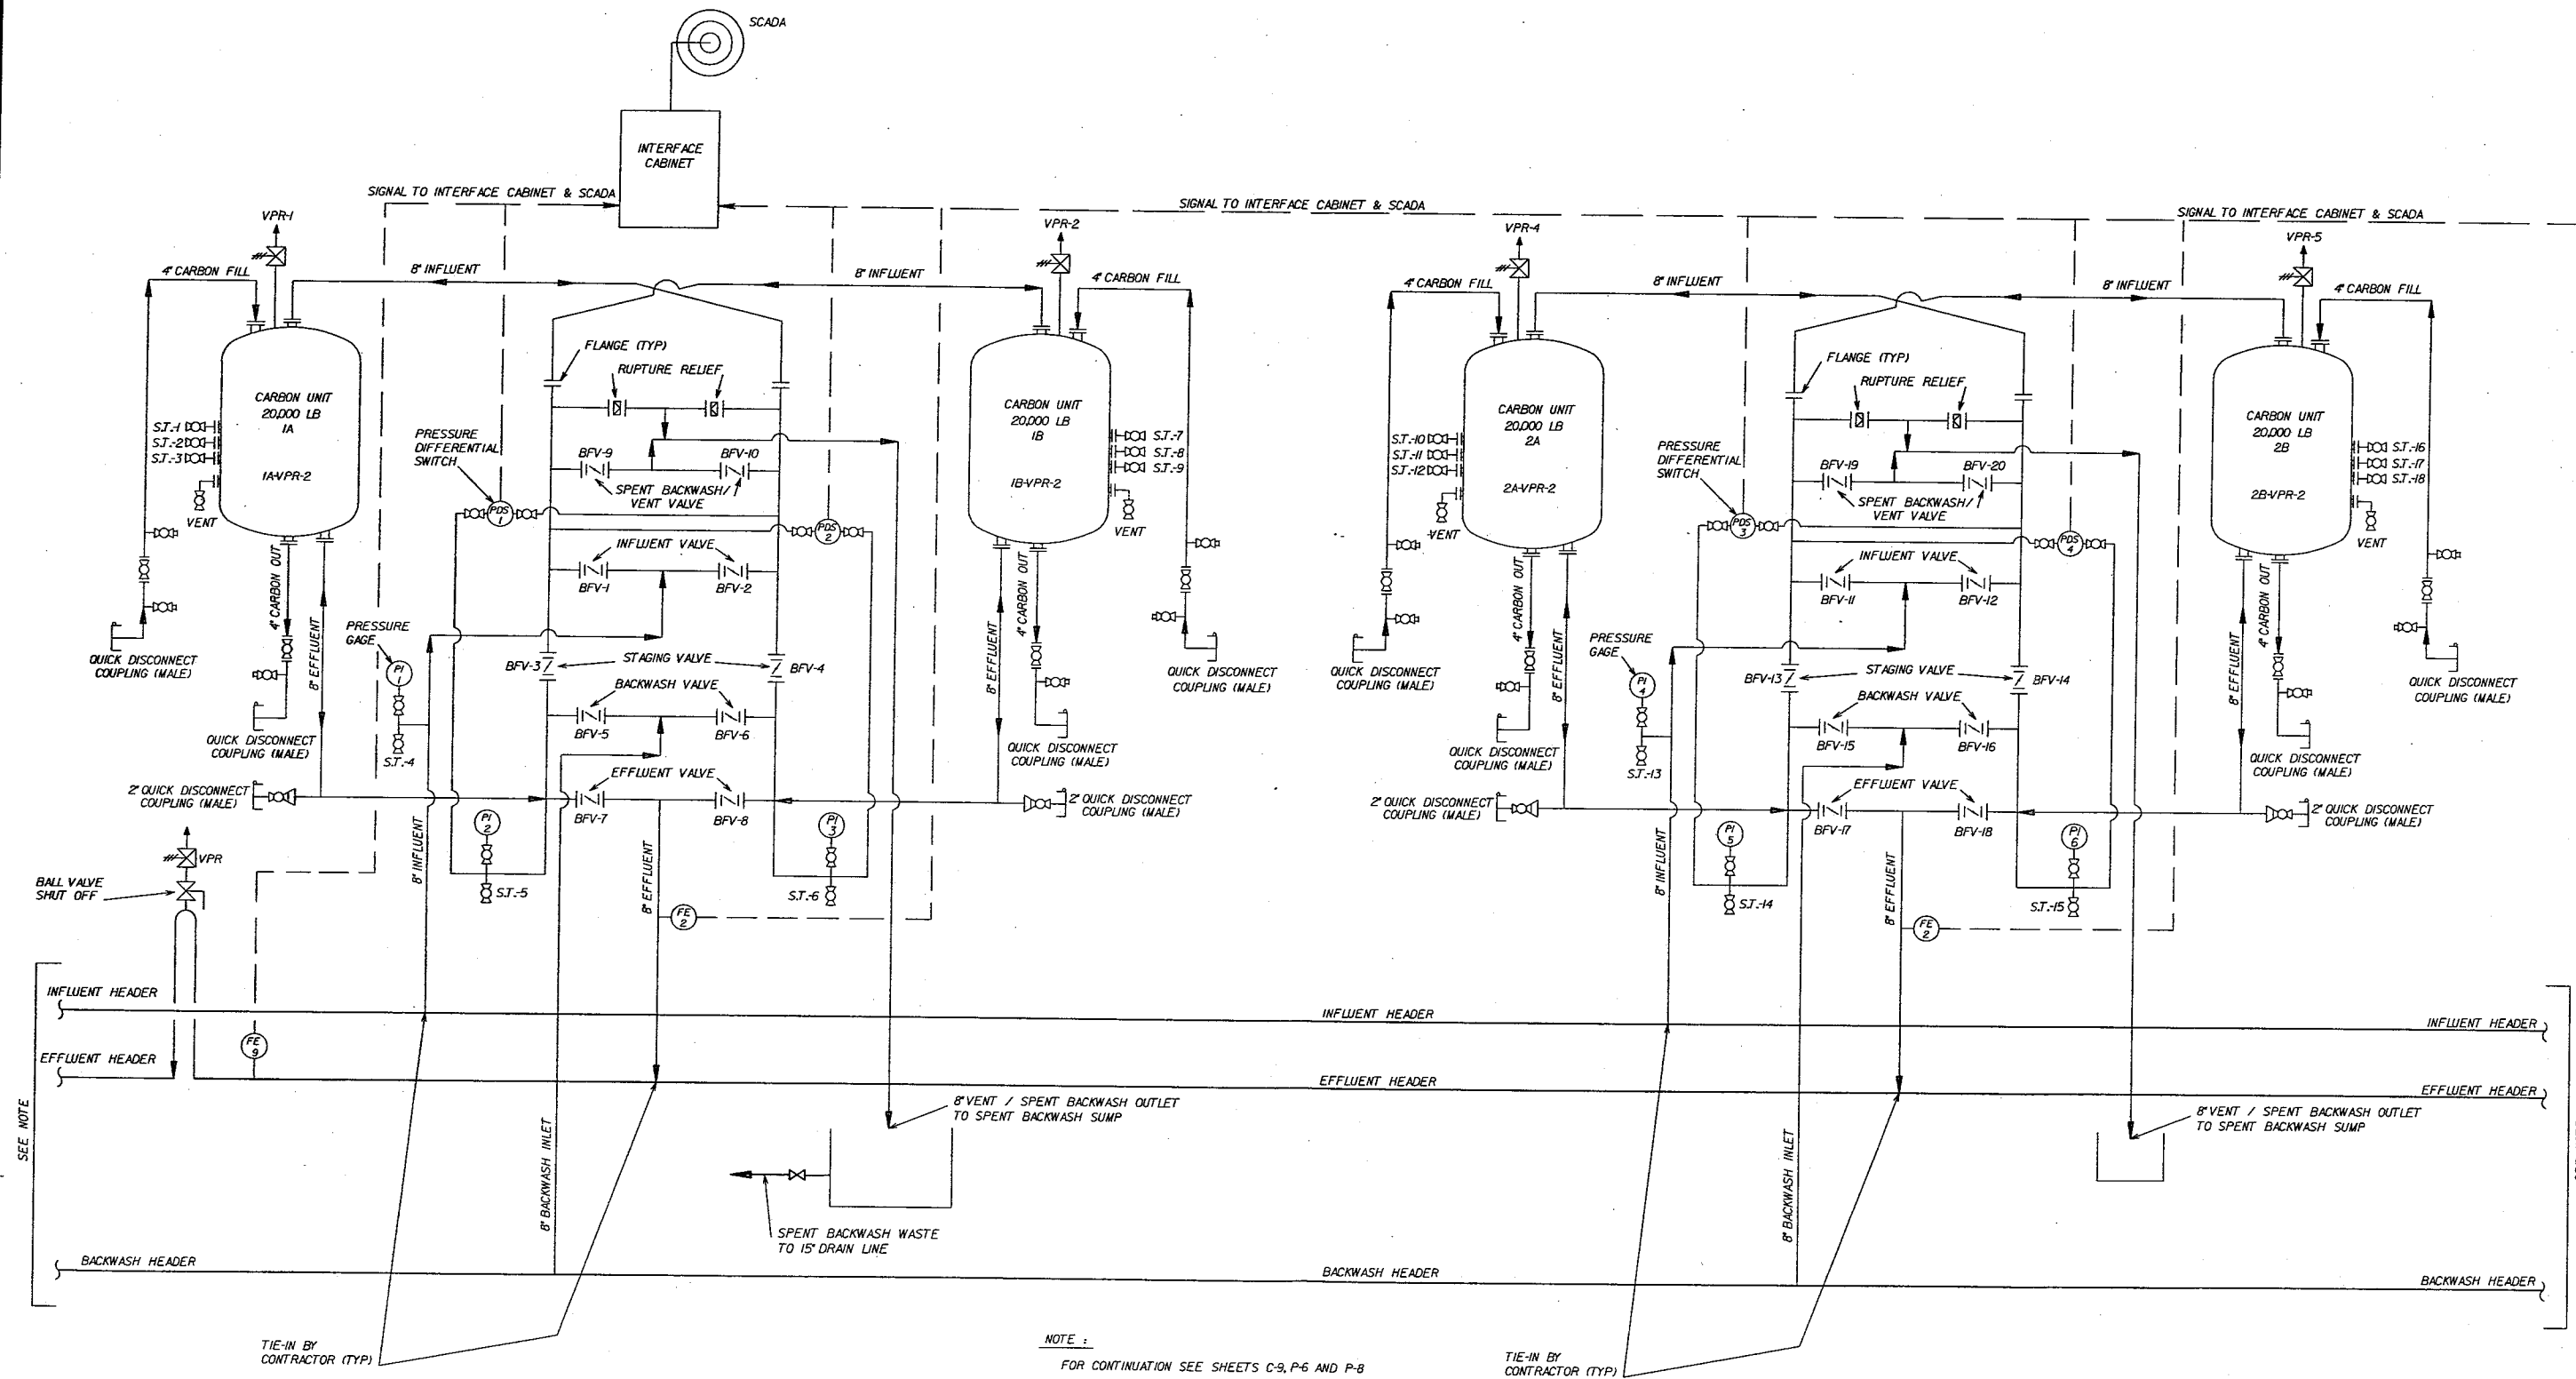


FOR CONTINUATION SEE SHEET P-9

NO.	DATE	DESCRIPTION	NO.	DATE	DESCRIPTION
11/98		RECORD DRAWING			
REVISIONS					

DESIGNED BY: PS
DRAWN BY: NDH
CHECKED BY: DHD

URS URS Consultants, Inc.
CONSULTING ENGINEERS
SACRAMENTO CALIFORNIA
JOB No. 62370

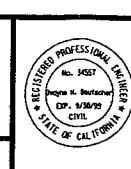

NEWMARK OU REMEDIAL DESIGN
NEWMARK GROUNDWATER
CONTAMINATION SUPERFUND SITE
NORTH & SOUTH PLANTS

WATERMAN PLANT
PIPING AND INSTRUMENTATION
DIAGRAM (P&ID)
Scale: NO SCALE Date: 6/97 Dwg. No.: P-8

"RECORD DRAWING"

JOB No. 62370.50
No. T:\JUSTS\PROJECTS\NEWMARK\ASBUIL\T\IP-9.DGN

FOR CONTINUATION SEE SHEET P-8

SEE NOTE

BACKWASH HEADER

TIE-IN BY CONTRACTOR (TYP)

NO.	DATE	DESCRIPTION	NO.	DATE	DESCRIPTION
11/98		RECORD DRAWING			
REVISIONS					

DESIGNED BY: PS
DRAWN BY: NDH
CHECKED BY: DHD

URS URS Consultants, Inc.
CONSULTING ENGINEERS
SACRAMENTO CALIFORNIA


JOB No. 62370



NEWMARK OU REMEDIAL DESIGN
NEWMARK GROUNDWATER
CONTAMINATION SUPERFUND SITE
NORTH & SOUTH PLANTS

WATERMAN PLANT
PIPING AND INSTRUMENTATION
DIAGRAM (P&ID)

Scale: NO SCALE Date: 6/97 Dwg. No.: P-9

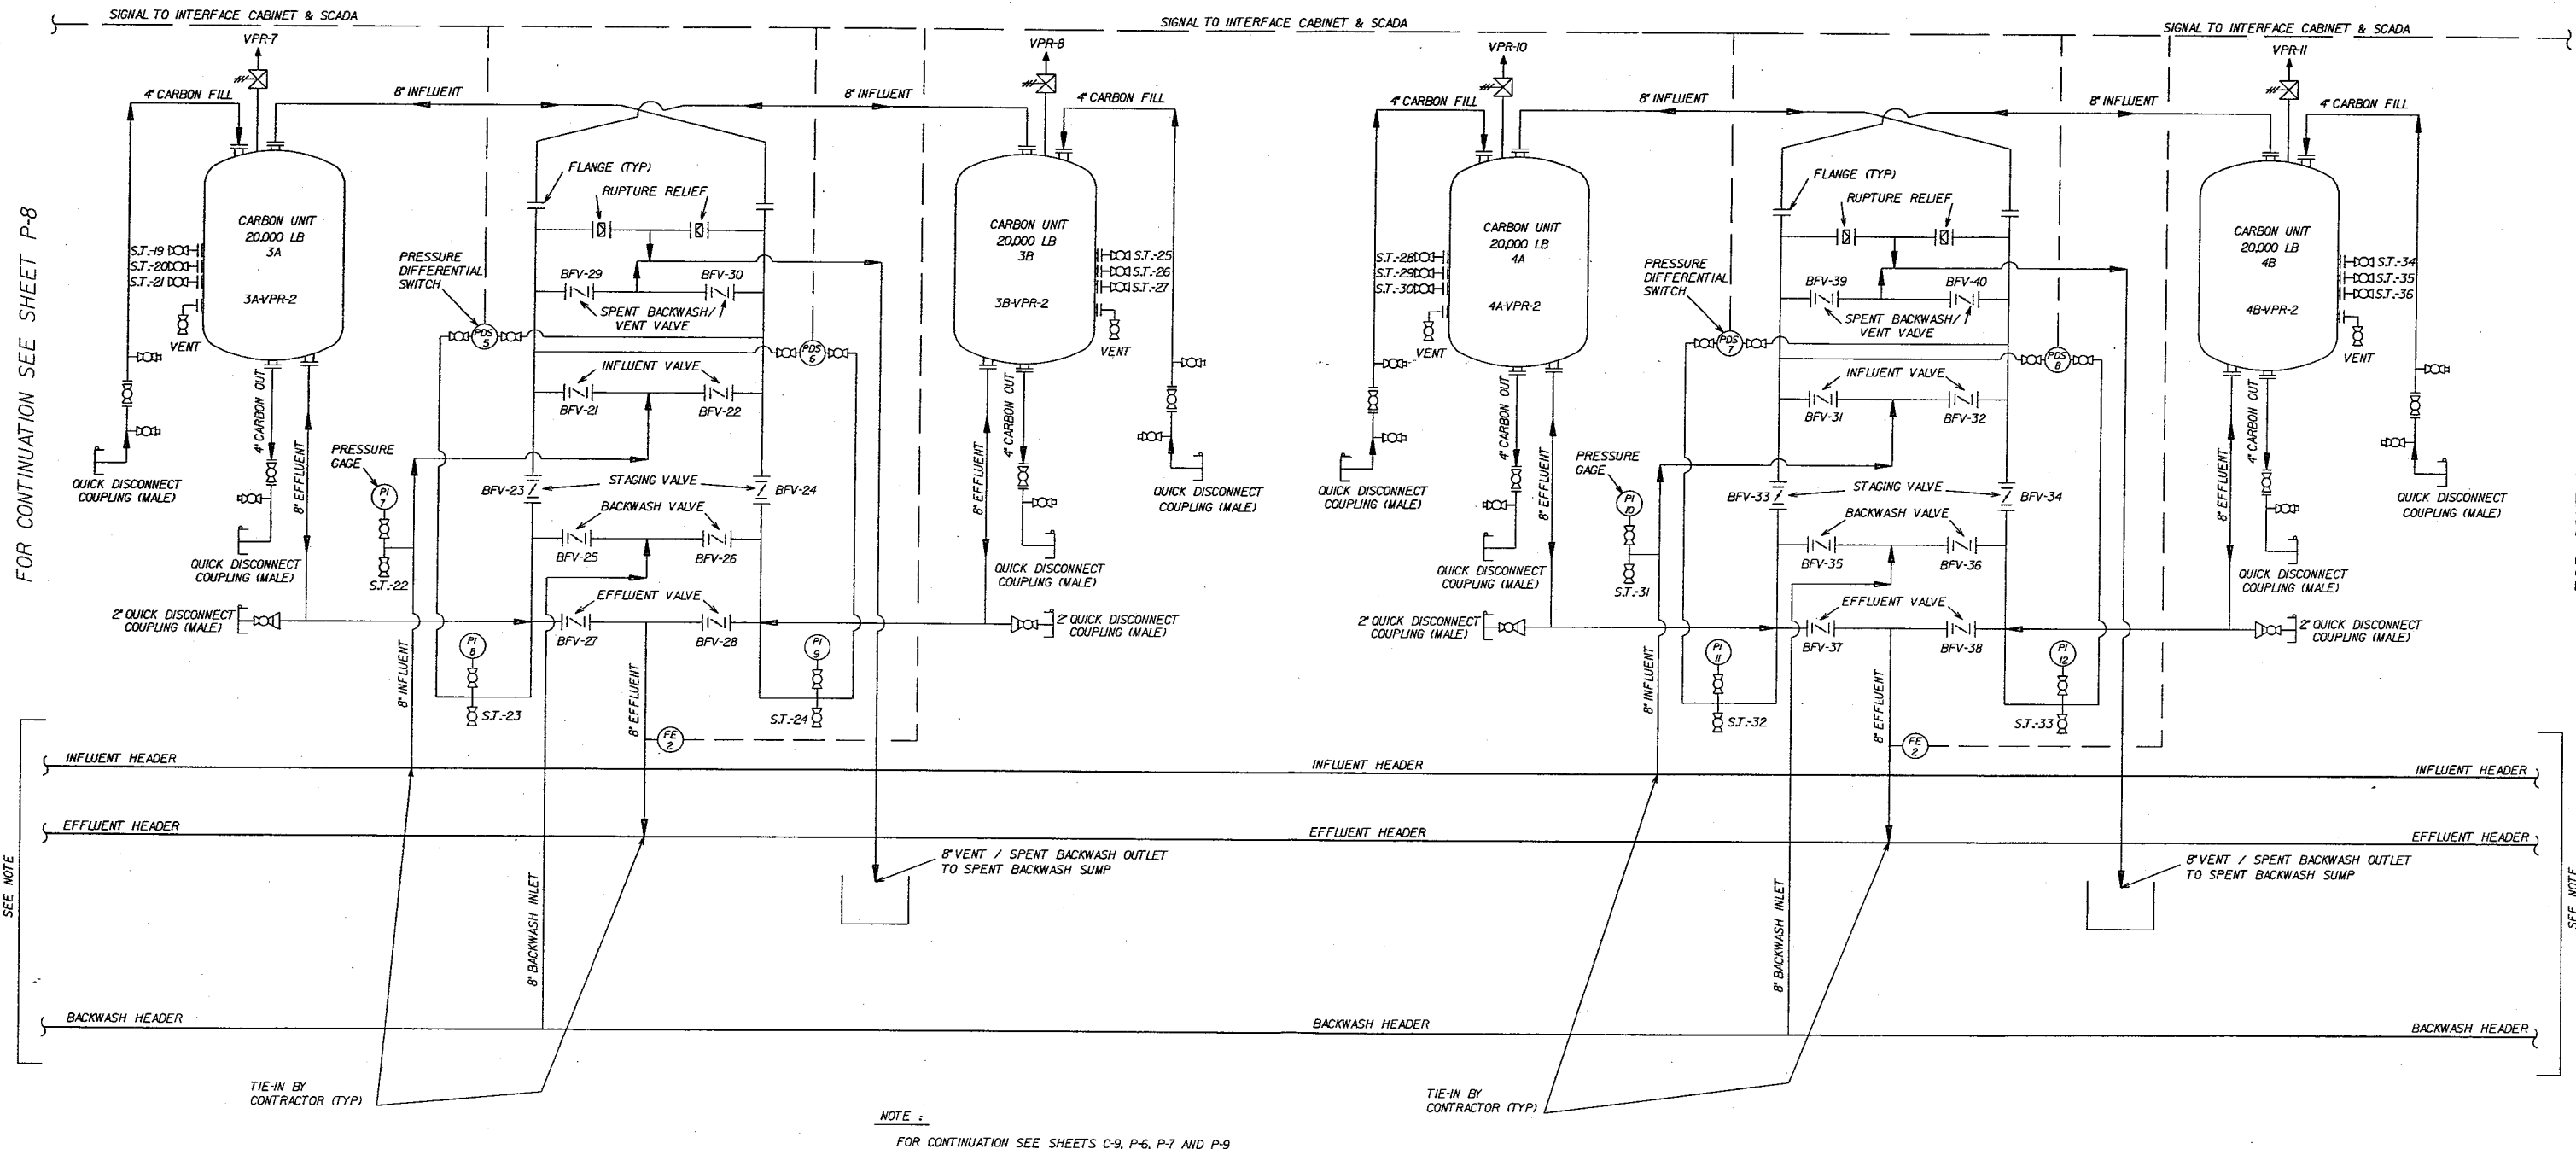


FOR CONTINUATION SEE SHEET P-10

SEE NOTE

BACKWASH HEADER

"RECORD DRAWING"

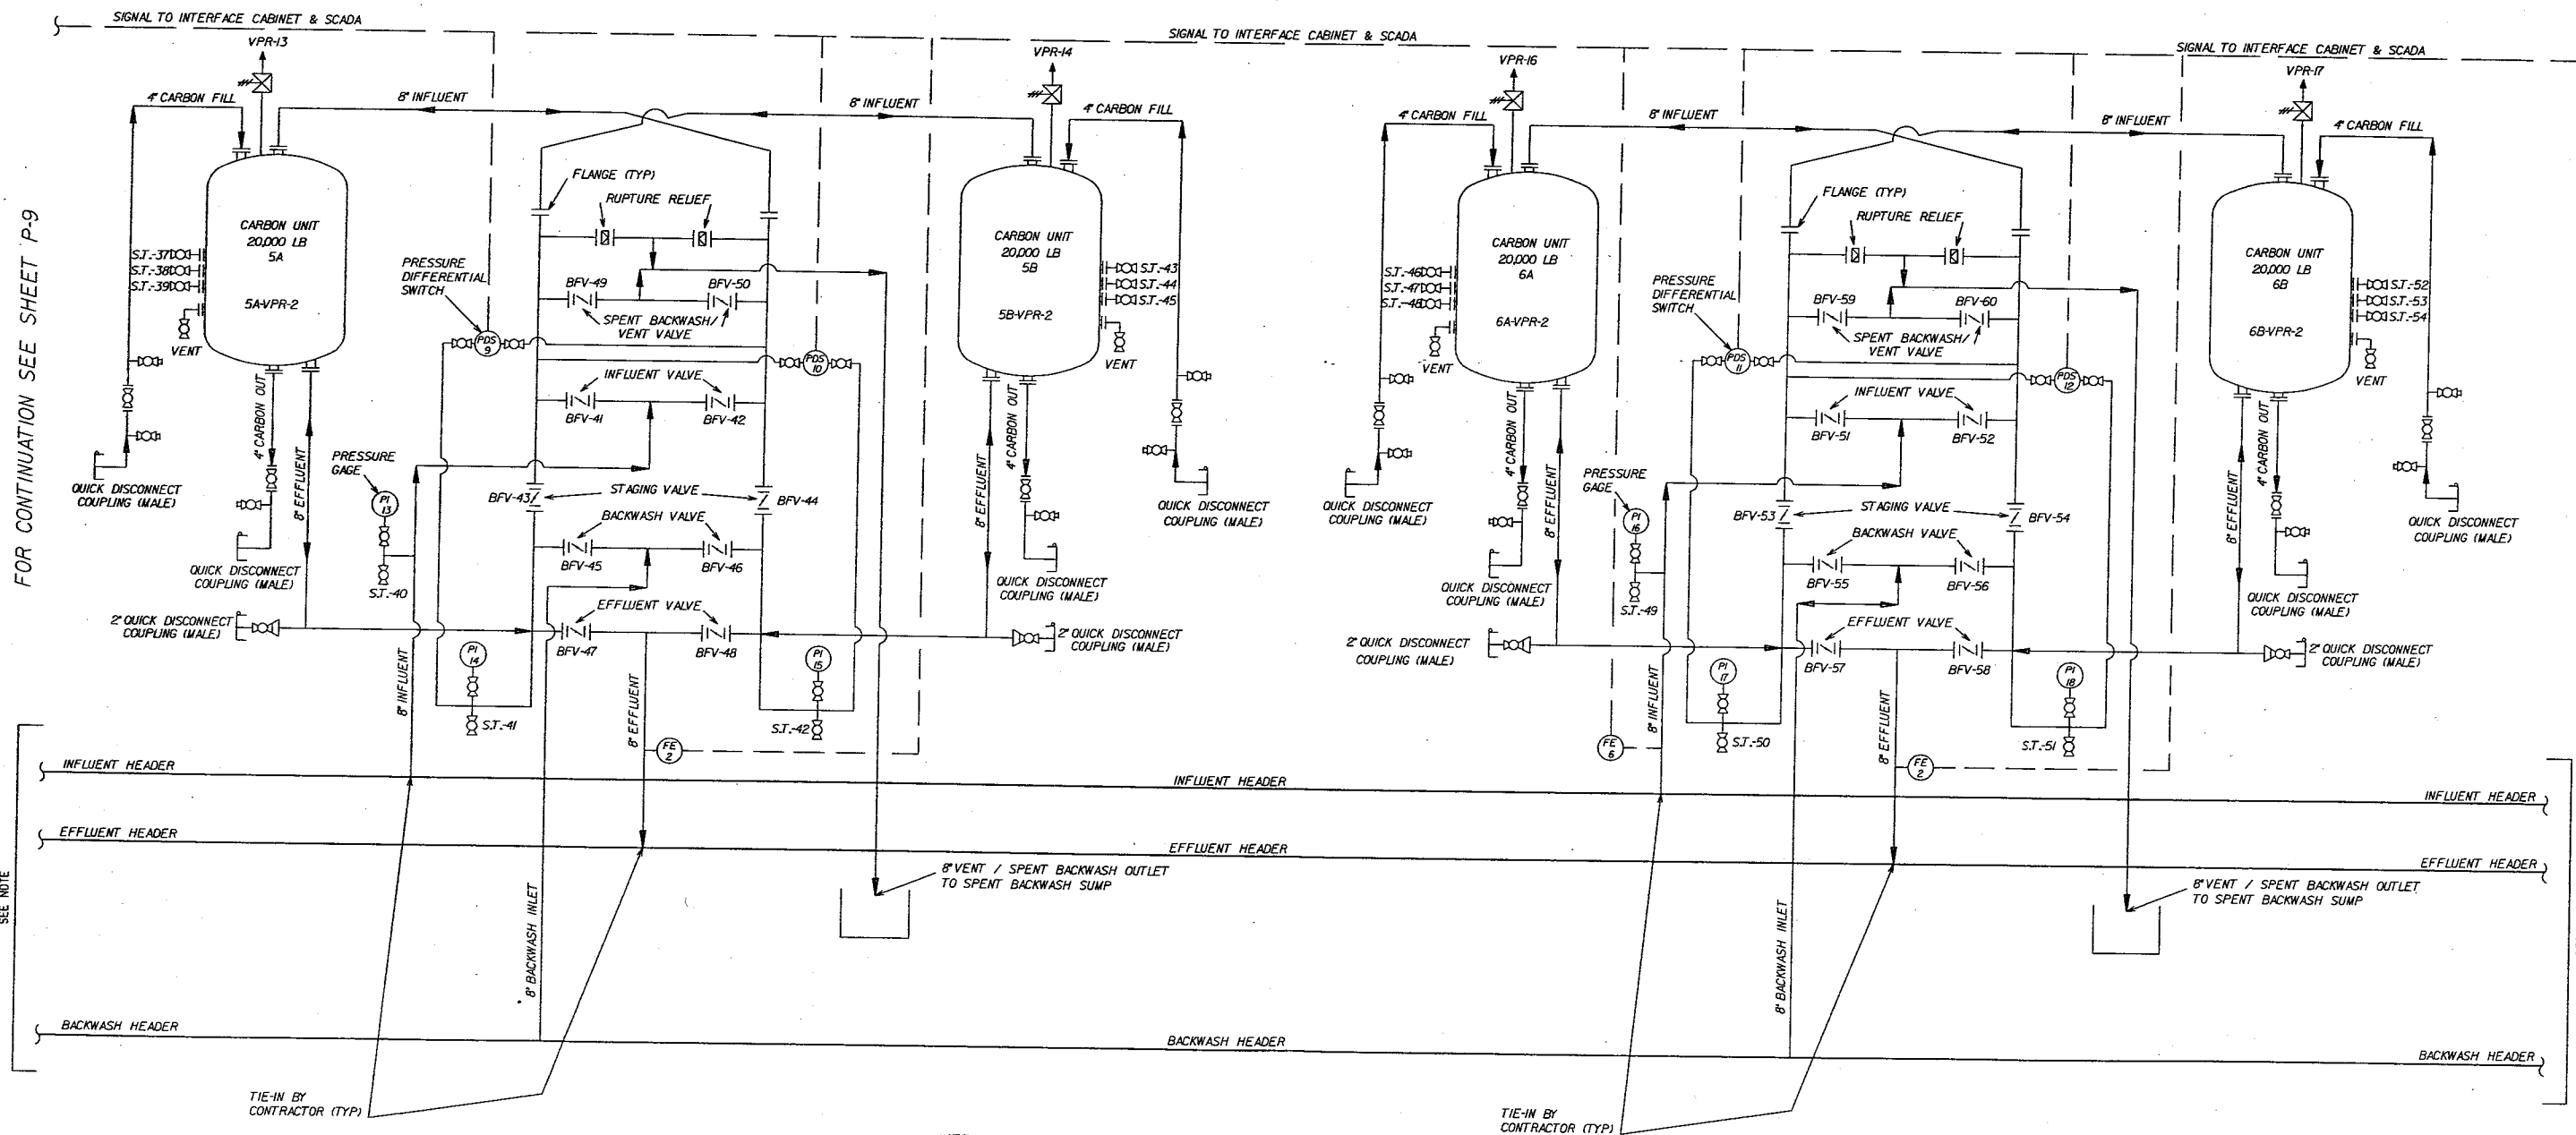

NOTE:
FOR CONTINUATION SEE SHEETS C-3, C-9, P-6, P-8 AND P-10.

JOB No. 62370.50 FILE No. T:\AUST5\PROJ\NEWMARK\ASBULT\IP-10.DGN

NO.	DATE	DESCRIPTION	NO.	DATE	DESCRIPTION
11/98		RECORD DRAWING			
REVISIONS					

DESIGNED BY: PS
DRAWN BY: NDH
CHECKED BY: DHD

URS URS Consultants, Inc.
CONSULTING ENGINEERS
SACRAMENTO CALIFORNIA

JOB No. 62370



NEWMARK OU REMEDIAL DESIGN
NEWMARK GROUNDWATER
CONTAMINATION SUPERFUND SITE
NORTH & SOUTH PLANTS

"RECORD DRAWING"

WATERMAN PLANT
PIPING AND INSTRUMENTATION
DIAGRAM (P&ID)

Scale: NO SCALE Date: 6/97 Dwg. No.: P-10

FOR CONTINUATION SEE SHEET P-10



	11/98	RECORD DRAWING			
NO.	DATE	DESCRIPTION	NO.	DATE	DESCRIPTION
REVISIONS					

DESIGNED BY: PS
DRAWN BY: NDH
CHECKED BY: DHD

URS URS Consultants, Inc.
CONSULTING ENGINEERS
SACRAMENTO CALIFORNIA

JOB No. 62370



NEWMARK OU REMEDIAL DESIGN
NEWMARK GROUNDWATER
CONTAMINATION SUPERFUND SITE
NORTH & SOUTH PLANTS

WATERMAN PLANT
PIPING AND INSTRUMENTATION
DIAGRAM (P&ID)

Scale: NO SCALE	Date: 6/97	Dwg. No.: P-11
--------------------	------------	----------------


CARBON UNITS VALVE SCHEDULE

* NEW VALVE ADDED AFTER VESSEL INSTALLATION
NOTE : FOR THE OPERATION OF VALVES IN EACH OPERATING MODE REFER TO THE O&M MANUAL

LOCATION			LOCATION			LOCATION			LOCATION			LOCATION		
1A & 1B			2A & 2B			3A & 3B			4A & 4B			5A & 5B		
VALVE NO.	SERVICE	ASBUILT NO.	VALVE NO.	SERVICE	ASBUILT NO.	VALVE NO.	SERVICE	ASBUILT NO.	VALVE NO.	SERVICE	ASBUILT NO.	VALVE NO.	SERVICE	ASBUILT NO.
VPR-1	AIR VACUUM/PRESSURE RELIEF	1A-VPR-1	VPR-4	AIR VACUUM/PRESSURE RELIEF	2A-VPR-1	VPR-7	AIR VACUUM/PRESSURE RELIEF	3A-VPR-1	VPR-10	AIR VACUUM/PRESSURE RELIEF	4A-VPR-1	VPR-13	AIR VACUUM/PRESSURE RELIEF	5A-VPR-1
VPR-2	AIR VACUUM/PRESSURE RELIEF	1B-VPR-1	VPR-5	AIR VACUUM/PRESSURE RELIEF	2B-VPR-1	VPR-8	AIR VACUUM/PRESSURE RELIEF	3B-VPR-1	VPR-11	AIR VACUUM/PRESSURE RELIEF	4B-VPR-1	VPR-14	AIR VACUUM/PRESSURE RELIEF	5B-VPR-1
* 1A-VPR-2	AIR VACUUM/PRESSURE RELIEF	1A-VPR-2	* 2A-VPR-2	AIR VACUUM/PRESSURE RELIEF	2A-VPR-2	* 3A-VPR-2	AIR VACUUM/PRESSURE RELIEF	3A-VPR-2	* 4A-VPR-2	AIR VACUUM/PRESSURE RELIEF	4A-VPR-2	* 5A-VPR-2	AIR VACUUM/PRESSURE RELIEF	5A-VPR-2
* 1B-VPR-2	AIR VACUUM/PRESSURE RELIEF	1B-VPR-2	* 2B-VPR-2	AIR VACUUM/PRESSURE RELIEF	2B-VPR-2	* 3B-VPR-2	AIR VACUUM/PRESSURE RELIEF	3B-VPR-2	* 4B-VPR-2	AIR VACUUM/PRESSURE RELIEF	4B-VPR-2	* 5B-VPR-2	AIR VACUUM/PRESSURE RELIEF	5B-VPR-2
S.T.-1	SAMPLE TAP CARBON UNIT 1A	1A-ST-1	S.T.-10	SAMPLE TAP CARBON UNIT 2A	2A-ST-1	S.T.-19	SAMPLE TAP CARBON UNIT 3A	3A-ST-1	S.T.-28	SAMPLE TAP CARBON UNIT 4A	4A-ST-1	S.T.-37	SAMPLE TAP CARBON UNIT 5A	5A-ST-1
S.T.-2	SAMPLE TAP CARBON UNIT 1A	1A-ST-2	S.T.-11	SAMPLE TAP CARBON UNIT 2A	2A-ST-2	S.T.-20	SAMPLE TAP CARBON UNIT 3A	3A-ST-2	S.T.-29	SAMPLE TAP CARBON UNIT 4A	4A-ST-2	S.T.-38	SAMPLE TAP CARBON UNIT 5A	5A-ST-2
S.T.-3	SAMPLE TAP CARBON UNIT 1A	1A-ST-3	S.T.-12	SAMPLE TAP CARBON UNIT 2A	2A-ST-3	S.T.-21	SAMPLE TAP CARBON UNIT 3A	3A-ST-3	S.T.-30	SAMPLE TAP CARBON UNIT 4A	4A-ST-3	S.T.-39	SAMPLE TAP CARBON UNIT 5A	5A-ST-3
S.T.-4	SAMPLE TAP INFLUENT	1A-ST-4	S.T.-13	SAMPLE TAP INFLUENT	2A-ST-4	S.T.-22	SAMPLE TAP INFLUENT	3A-ST-4	S.T.-31	SAMPLE TAP INFLUENT	4A-ST-4	S.T.-40	SAMPLE TAP INFLUENT	5A-ST-4
S.T.-5	SAMPLE TAP INTERMEDIATE	1A-ST-5,1B-ST-5	S.T.-14	SAMPLE TAP INTERMEDIATE	2A-ST-5,2B-ST-5	S.T.-23	SAMPLE TAP INTERMEDIATE	3A-ST-5,3B-ST-5	S.T.-32	SAMPLE TAP INTERMEDIATE	4A-ST-5,4B-ST-5	S.T.-41	SAMPLE TAP INTERMEDIATE	5A-ST-5,5B-ST-5
S.T.-6	SAMPLE TAP EFFLUENT	1B-ST-4	S.T.-15	SAMPLE TAP EFFLUENT	2B-ST-4	S.T.-24	SAMPLE TAP EFFLUENT	3B-ST-4	S.T.-33	SAMPLE TAP EFFLUENT	4B-ST-4	S.T.-42	SAMPLE TAP EFFLUENT	5B-ST-4
S.T.-7	SAMPLE TAP CARBON UNIT 1B	1B-ST-1	S.T.-16	SAMPLE TAP CARBON UNIT 2B	2B-ST-1	S.T.-25	SAMPLE TAP CARBON UNIT 3B	3B-ST-1	S.T.-34	SAMPLE TAP CARBON UNIT 4B	4B-ST-1	S.T.-43	SAMPLE TAP CARBON UNIT 5B	5B-ST-1
S.T.-8	SAMPLE TAP CARBON UNIT 1B	1B-ST-2	S.T.-17	SAMPLE TAP CARBON UNIT 2B	2B-ST-2	S.T.-26	SAMPLE TAP CARBON UNIT 3B	3B-ST-2	S.T.-35	SAMPLE TAP CARBON UNIT 4B	4B-ST-2	S.T.-44	SAMPLE TAP CARBON UNIT 5B	5B-ST-2
S.T.-9	SAMPLE TAP CARBON UNIT 1B	1B-ST-3	S.T.-18	SAMPLE TAP CARBON UNIT 2B	2B-ST-3	S.T.-27	SAMPLE TAP CARBON UNIT 3B	3B-ST-3	S.T.-36	SAMPLE TAP CARBON UNIT 4B	4B-ST-3	S.T.-45	SAMPLE TAP CARBON UNIT 5B	5B-ST-3
BFV-1	INFLUENT	1A-BFV-2	BFV-11	INFLUENT	2A-BFV-2	BFV-21	INFLUENT	3A-BFV-2	BFV-31	INFLUENT	4A-BFV-2	BFV-41	INFLUENT	5A-BFV-2
BFV-2	INFLUENT	1B-BFV-2	BFV-12	INFLUENT	2B-BFV-2	BFV-22	INFLUENT	3B-BFV-2	BFV-32	INFLUENT	4B-BFV-2	BFV-42	INFLUENT	5B-BFV-2
BFV-3	STAGING	1A-BFV-3	BFV-13	STAGING	2A-BFV-3	BFV-23	STAGING	3A-BFV-3	BFV-33	STAGING	4A-BFV-3	BFV-43	STAGING	5A-BFV-3
BFV-4	STAGING	1B-BFV-3	BFV-14	STAGING	2B-BFV-3	BFV-24	STAGING	3B-BFV-3	BFV-34	STAGING	4B-BFV-3	BFV-44	STAGING	5B-BFV-3
BFV-5	BACKWASH	1A-BFV-4	BFV-15	BACKWASH	2A-BFV-4	BFV-25	BACKWASH	3A-BFV-4	BFV-35	BACKWASH	4A-BFV-4	BFV-45	BACKWASH	5A-BFV-4
BFV-6	BACKWASH	1B-BFV-4	BFV-16	BACKWASH	2B-BFV-4	BFV-26	BACKWASH	3B-BFV-4	BFV-36	BACKWASH	4B-BFV-4	BFV-46	BACKWASH	5B-BFV-4
BFV-7	EFFLUENT	1A-BFV-5	BFV-17	EFFLUENT	2A-BFV-5	BFV-27	EFFLUENT	3A-BFV-5	BFV-37	EFFLUENT	4A-BFV-5	BFV-47	EFFLUENT	5A-BFV-5
BFV-8	EFFLUENT	1B-BFV-5	BFV-18	EFFLUENT	2B-BFV-5	BFV-28	EFFLUENT	3B-BFV-5	BFV-38	EFFLUENT	4B-BFV-5	BFV-48	EFFLUENT	5B-BFV-5
BFV-9	SPENT BACKWASH/VENT	1A-BFV-1	BFV-19	SPENT BACKWASH/VENT	2A-BFV-1	BFV-29	SPENT BACKWASH/VENT	3A-BFV-1	BFV-39	SPENT BACKWASH/VENT	4A-BFV-1	BFV-49	SPENT BACKWASH/VENT	5A-BFV-1
BFV-10	SPENT BACKWASH/VENT	1B-BFV-1	BFV-20	SPENT BACKWASH/VENT	2B-BFV-1	BFV-30	SPENT BACKWASH/VENT	3B-BFV-1	BFV-40	SPENT BACKWASH/VENT	4B-BFV-1	BFV-50	SPENT BACKWASH/VENT	5B-BFV-1

LOCATION			LOCATION			LOCATION		
6A & 6B			7A & 7B			8A & 8B		
VALVE NO.	SERVICE	ASBUILT NO.	VALVE NO.	SERVICE	ASBUILT NO.	VALVE NO.	SERVICE	ASBUILT NO.
VPR-16	AIR VACUUM/PRESSURE RELIEF	6A-VPR-1	VPR-19	AIR VACUUM/PRESSURE RELIEF	7A-VPR-1	VPR-22	AIR VACUUM/PRESSURE RELIEF	8A-VPR-1
VPR-17	AIR VACUUM/PRESSURE RELIEF	6B-VPR-1	VPR-20	AIR VACUUM/PRESSURE RELIEF	7B-VPR-1	VPR-23	AIR VACUUM/PRESSURE RELIEF	8B-VPR-1
* 6A-VPR-2	AIR VACUUM/PRESSURE RELIEF	6A-VPR-2	* 7A-VPR-2	AIR VACUUM/PRESSURE RELIEF	7A-VPR-2	* 8A-VPR-2	AIR VACUUM/PRESSURE RELIEF	8A-VPR-2
* 6B-VPR-2	AIR VACUUM/PRESSURE RELIEF	6B-VPR-2	* 7B-VPR-2	AIR VACUUM/PRESSURE RELIEF	7B-VPR-2	* 8B-VPR-2	AIR VACUUM/PRESSURE RELIEF	8B-VPR-2
S.T.-46	SAMPLE TAP CARBON UNIT 6A	6A-ST-1	S.T.-55	SAMPLE TAP CARBON UNIT 7A	7A-ST-1	S.T.-64	SAMPLE TAP CARBON UNIT 8A	8A-ST-1
S.T.-47	SAMPLE TAP CARBON UNIT 6A	6A-ST-2	S.T.-56	SAMPLE TAP CARBON UNIT 7A	7A-ST-2	S.T.-65	SAMPLE TAP CARBON UNIT 8A	8A-ST-2
S.T.-48	SAMPLE TAP CARBON UNIT 6A	6A-ST-3	S.T.-57	SAMPLE TAP CARBON UNIT 7A	7A-ST-3	S.T.-66	SAMPLE TAP CARBON UNIT 8A	8A-ST-3
S.T.-49	SAMPLE TAP INFLUENT	6A-ST-4	S.T.-58	SAMPLE TAP INFLUENT	7A-ST-4	S.T.-67	SAMPLE TAP INFLUENT	8A-ST-4
S.T.-50	SAMPLE TAP INTERMEDIATE	6A-ST-5,6B-ST-5	S.T.-59	SAMPLE TAP INTERMEDIATE	7A-ST-5,7B-ST-5	S.T.-68	SAMPLE TAP INTERMEDIATE	8A-ST-5,8B-ST-5
S.T.-51	SAMPLE TAP EFFLUENT	6B-ST-4	S.T.-60	SAMPLE TAP EFFLUENT	7B-ST-4	S.T.-69	SAMPLE TAP EFFLUENT	8B-ST-4
S.T.-52	SAMPLE TAP CARBON UNIT 6B	6B-ST-1	S.T.-61	SAMPLE TAP CARBON UNIT 7B	7B-ST-1	S.T.-70	SAMPLE TAP CARBON UNIT 8B	8B-ST-1
S.T.-53	SAMPLE TAP CARBON UNIT 6B	6B-ST-2	S.T.-62	SAMPLE TAP CARBON UNIT 7B	7B-ST-2	S.T.-71	SAMPLE TAP CARBON UNIT 8B	8B-ST-2
S.T.-54	SAMPLE TAP CARBON UNIT 6B	6B-ST-3	S.T.-63	SAMPLE TAP CARBON UNIT 7B	7B-ST-3	S.T.-72	SAMPLE TAP CARBON UNIT 8B	8B-ST-3
BFV-51	INFLUENT	6A-BFV-2	BFV-61	INFLUENT	7A-BFV-2	BFV-71	INFLUENT	8A-BFV-2
BFV-52	INFLUENT	6B-BFV-2	BFV-62	INFLUENT	7B-BFV-2	BFV-72	INFLUENT	8B-BFV-2
BFV-53	STAGING	6A-BFV-3	BFV-63	STAGING	7A-BFV-3	BFV-73	STAGING	8A-BFV-3
BFV-54	STAGING	6B-BFV-3	BFV-64	STAGING	7B-BFV-3	BFV-74	STAGING	8B-BFV-3
BFV-55	BACKWASH	6A-BFV-4	BFV-65	BACKWASH	7A-BFV-4	BFV-75	BACKWASH	8A-BFV-4
BFV-56	BACKWASH	6B-BFV-4	BFV-66	BACKWASH	7B-BFV-4	BFV-76	BACKWASH	8B-BFV-4
BFV-57	EFFLUENT	6A-BFV-5	BFV-67	EFFLUENT	7A-BFV-5	BFV-77	EFFLUENT	8A-BFV-5
BFV-58	EFFLUENT	6B-BFV-5	BFV-68	EFFLUENT	7B-BFV-5	BFV-78	EFFLUENT	8B-BFV-5
BFV-59	SPENT BACKWASH/VENT	6A-BFV-1	BFV-69	SPENT BACKWASH/VENT	7A-BFV-1	BFV-79	SPENT BACKWASH/VENT	8A-BFV-1
BFV-60	SPENT BACKWASH/VENT	6B-BFV-1	BFV-70	SPENT BACKWASH/VENT	7B-BFV-1	BFV-80	SPENT BACKWASH/VENT	8B-BFV-1

11/98	RECORD DRAWING				
NO.	DATE	DESCRIPTION	NO.	DATE	DESCRIPTION
REVISIONS					


DESIGNED BY: PS	URS URS Consultants, Inc. CONSULTING ENGINEERS SACRAMENTO CALIFORNIA		NEWMARK OU REMEDIAL DESIGN NEWMARK GROUNDWATER CONTAMINATION SUPERFUND SITE NORTH & SOUTH PLANTS	WATERMAN PLANT CARBON UNITS VALVE SCHEDULE		
DRAWN BY: NDH				Scale: NO SCALE	Date: 6/97	Dwg. No.: P-12
CHECKED BY: DHD						

JOB No. 62370	
---------------	--

"RECORD DRAWING"

E No. T-101575 PROJ NEWMARK ASBULTY C-1.00N

JOB No. 62370.50

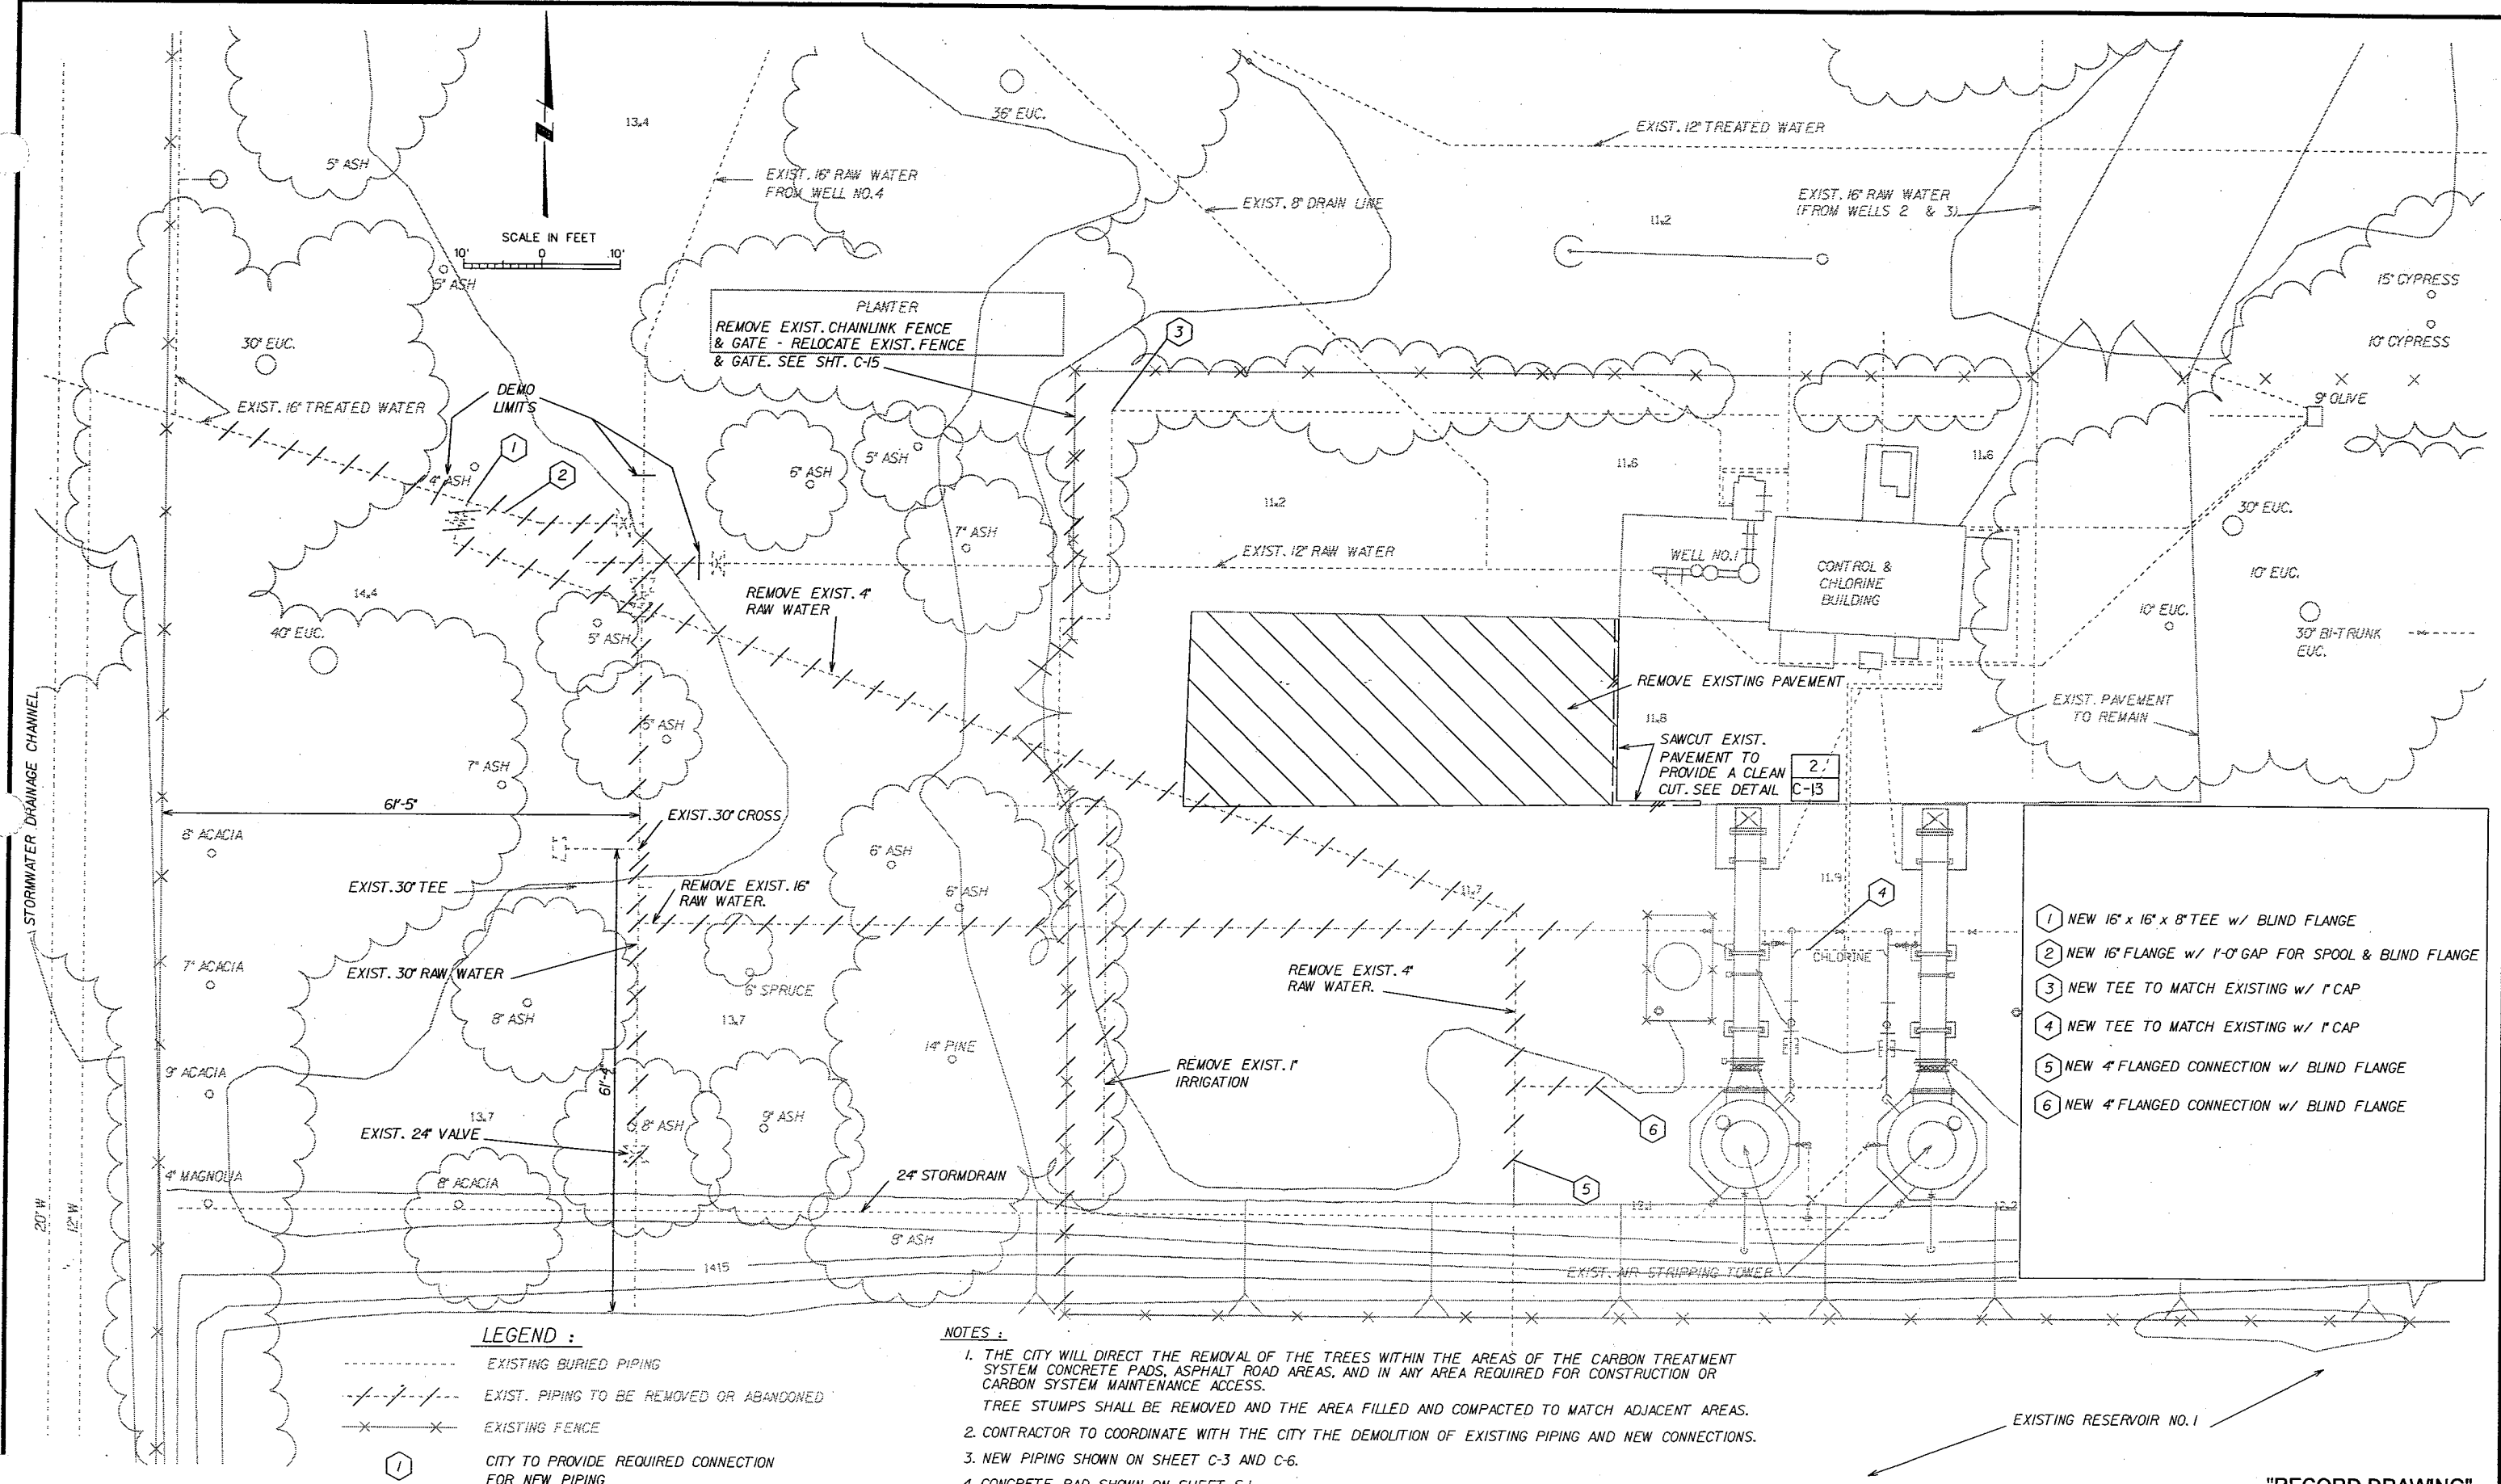

LEGEND :

- EXISTING BURIED PIPING
- - - - - EXIST. PIPING TO BE REMOVED OR ABANDONED
- x - x - EXISTING FENCE
- ① CITY TO PROVIDE REQUIRED CONNECTION FOR NEW PIPING

NOTES :


1. THE CITY WILL DIRECT THE REMOVAL OF THE TREES WITHIN THE AREAS OF THE CARBON TREATMENT SYSTEM CONCRETE PADS, ASPHALT ROAD AREAS, AND IN ANY AREA REQUIRED FOR CONSTRUCTION OR CARBON SYSTEM MAINTENANCE ACCESS.
- TREE STUMPS SHALL BE REMOVED AND THE AREA FILLED AND COMPACTED TO MATCH ADJACENT AREAS.
2. CONTRACTOR TO COORDINATE WITH THE CITY THE DEMOLITION OF EXISTING PIPING AND NEW CONNECTIONS.
3. NEW PIPING SHOWN ON SHEET C-3 AND C-6.
4. CONCRETE PAD SHOWN ON SHEET S-1.

NO.	DATE	DESCRIPTION	NO.	DATE	DESCRIPTION
11/98		RECORD DRAWING			
REVISIONS					

DESIGNED BY: PS
 DRAWN BY: NDH
 CHECKED BY: DHD

URS URS Consultants, Inc.
 CONSULTING ENGINEERS
 SACRAMENTO CALIFORNIA

JOB No. 62370

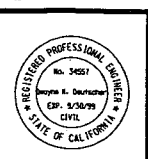


NEWMARK OU REMEDIAL DESIGN
NEWMARK GROUNDWATER
CONTAMINATION SUPERFUND SITE
NORTH & SOUTH PLANTS

NORTH PLANT		
DEMOLITION PLAN		
Scale: AS NOTED	Date: 6/97	Dwg. No.: C-1

"RECORD DRAWING"

JOB No. 62370.50
E No. I:\JUST5\PROJ\NEWMARK\ASBULT\ C-2.DGN

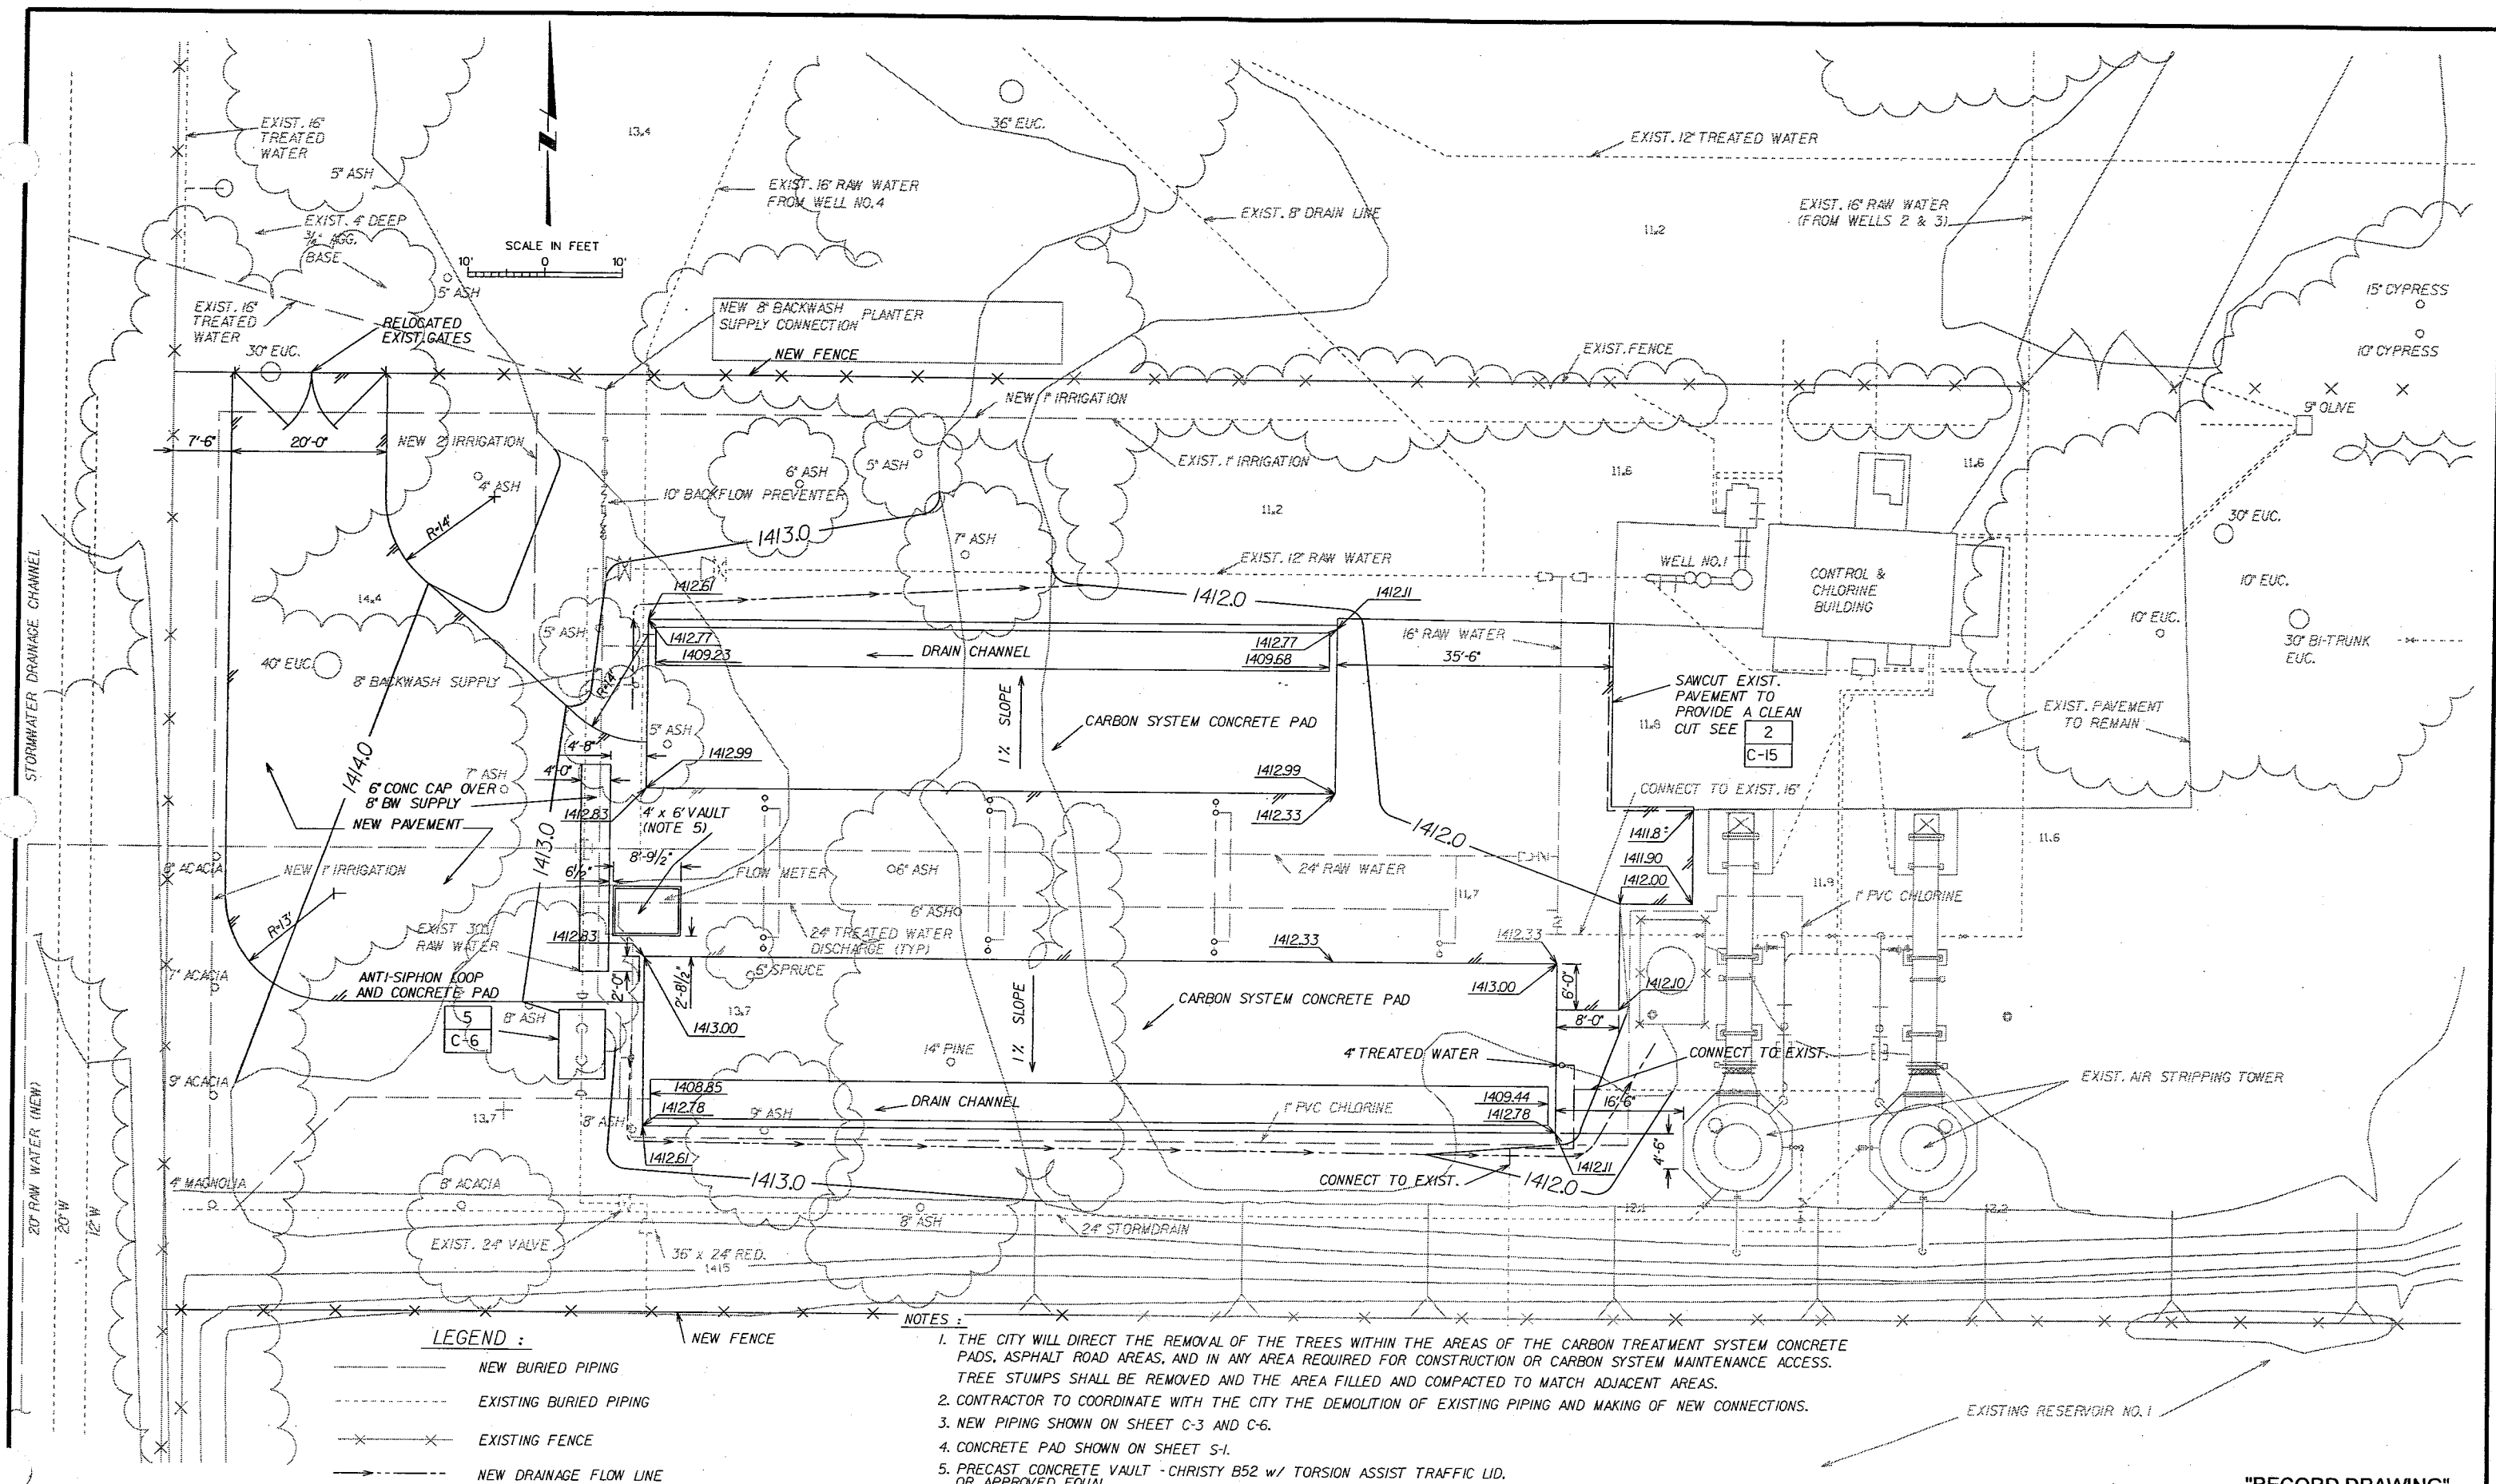

LEGEND :

- NEW BURIED PIPING
- - - EXISTING BURIED PIPING
- x-x- EXISTING FENCE
- - - - - NEW DRAINAGE FLOW LINE


NOTES :

1. THE CITY WILL DIRECT THE REMOVAL OF THE TREES WITHIN THE AREAS OF THE CARBON TREATMENT SYSTEM CONCRETE PADS, ASPHALT ROAD AREAS, AND IN ANY AREA REQUIRED FOR CONSTRUCTION OR CARBON SYSTEM MAINTENANCE ACCESS. TREE STUMPS SHALL BE REMOVED AND THE AREA FILLED AND COMPACTED TO MATCH ADJACENT AREAS.
2. CONTRACTOR TO COORDINATE WITH THE CITY THE DEMOLITION OF EXISTING PIPING AND MAKING OF NEW CONNECTIONS.
3. NEW PIPING SHOWN ON SHEET C-3 AND C-6.
4. CONCRETE PAD SHOWN ON SHEET S-1.
5. PRECAST CONCRETE VAULT - CHRISTY B52 w/ TORSION ASSIST TRAFFIC LID. OR APPROVED EQUAL.

NO.	DATE	DESCRIPTION	NO.	DATE	DESCRIPTION
11/98		RECORD DRAWING			
REVISIONS					


DESIGNED BY: PS
DRAWN BY: NDH
CHECKED BY: DHD

URS URS Consultants, Inc.
CONSULTING ENGINEERS
SACRAMENTO CALIFORNIA

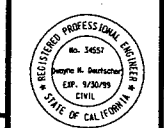

NEWMARK OU REMEDIAL DESIGN
NEWMARK GROUNDWATER
CONTAMINATION SUPERFUND SITE
NORTH & SOUTH PLANTS

"RECORD DRAWING"
NORTH PLANT
SITE GRADING AND PAVING
Scale: AS NOTED
Date: 9/97
Dwg. No.: C-2

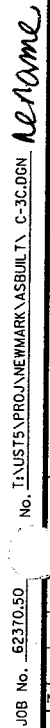

Scale: AS NOTED	Date: 9/97	Dwg. No.: C-3
--------------------	------------	---------------